

MISSISSIPPI DEPARTMENT OF NATURAL RESOURCES

Bureau of Land and Water Resources

Southport Mall

P.O. Box 10631

Jackson, Mississippi 39209

WATER WELL DRILLERS LOG

Jackson
J
2150

6/17 1983 Lyman Well Co. Jackson County
date well completed firm name county well located


LANDOWNER:	description of formations encountered	from	to
Raynell Basarge 6705 Neshobe St. Biloxi (mailing address) 39530	Red Sand & Pea Gravel Gumbo Clay Good sand	0 80 90	80 90 135
WELL LOCATION:			
sec. <u>14</u> T <u>6</u> N. R. <u>9</u> E <u>5</u> miles <u>N/W</u> of <u>Ocean Springs</u> (distance) (direction) (nearest town)			
WELL PURPOSE: <u>HOME</u> (home, irrigation, municipal, industrial)			
WELL COMPLETION DATA:			
(1) diameter (Inches) <u>2"</u>			
(2) total depth (feet) <u>135</u>			
(3) static water level (feet) <u>20</u> below above top of ground.			
(4) casing <u>PVC</u> , <u>125</u> (material) (depth) <u>2 1/2</u> (size) if telescope see back.			
(5) screen <u>10'</u> , <u>135</u> (length) (depth to top)			
<u>2"</u> <u>PVC</u> (size) (material)			
(6) pump <u>1</u> <u>12</u> (HP) (yield gpm)			
<u>Elec.</u> (type power)			
(7) electric log <u>NO</u> (yes or no)			
<u>NO</u> (organization running log)			
(8) how well bottom plugged <u>Sand</u> <u>shut</u>			
DRILLERS REMARKS:			

DEPT. OF NATURAL RESOURCES
BUREAU OF LAND & WATER RESOURCES

NOV - 3 1983
RECEIVED

If well telescopes please sketch and show depths.

GROUND LEVEL

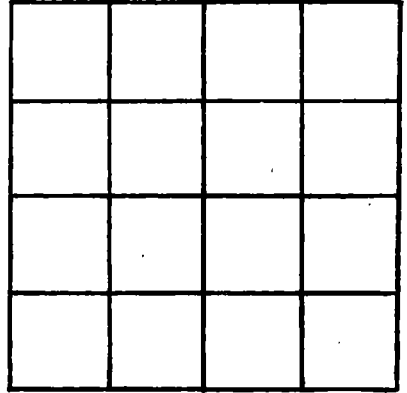

SECTION _____

Please indicate well location X.

ADDITIONAL INFORMATION

If more than one screen,
show locations of each on sketch.