

**MISSISSIPPI DEPARTMENT OF NATURAL RESOURCES**  
**Bureau of Land and Water Resources**  
 Southport Mall  
 P.O. Box 10631  
 Jackson, Mississippi 39209  
**WATER WELL DRILLERS LOG**

Jackson  
8-2153

10-11-83 19 Coast Water Well Sew. Jackson.  
 date well completed firm name county well located

LANDOWNER: Carl Durling  
P.O. Box 325 AA  
Ocean Springs, Miss.  
 (mailing address) 33544

WELL LOCATION:  
 sec. 3 T. 6 S. R. 8 W.  
5 1/2 miles W of WADSWORTH  
 (distance) (direction) (nearest town)

WELL PURPOSE: Home  
 (home, irrigation, municipal, industrial)

WELL COMPLETION DATA:  
 (1) diameter (inches) 2"  
 (2) total depth (feet) 147'  
 (3) static water level (feet) 47' below top of ground.  
 (4) casing PVC, 137'  
 (material) (depth)  
2" If telescope see back.  
 (size)  
 (5) screen 10', 137'  
 (length) (depth to top)  
2" PVC  
 (size) (material)  
 (6) pump 1 h.p., 7 1/2  
 (HP) (yield gpm)  
elec.  
 (type power)  
 (7) electric log No.  
 (yes or no)  
 \_\_\_\_\_  
 (organization running log)

description of formations encountered	from	to
<u>Top soil</u>	<u>0</u>	<u>2'</u>
<u>Red Clay</u>	<u>2'</u>	<u>21'</u>
<u>Red Coarse sand</u>	<u>21'</u>	<u>86'</u>
<u>Red Clay &amp; Struck</u>		
<u>of sand</u>	<u>86'</u>	<u>101'</u>
<u>Red Coarse sand</u>	<u>101'</u>	<u>137'</u>
<u>Red med. sand</u>	<u>137'</u>	<u>147'</u>

DEPT. OF NATURAL RESOURCES  
 BUREAU OF LAND & WATER RESOURCES

DEC 19 1983


**RECEIVED**

(8) How well bottom plugged  
Back Wash Valve

DRILLERS REMARKS:

If well telescopes please sketch and show depths.

GROUND LEVEL

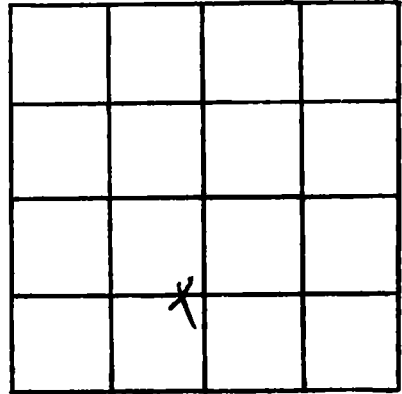

SECTION 3

Please indicate well location X.

ADDITIONAL INFORMATION

---

---

If more than one screen, show locations of each on sketch.