

MISSISSIPPI DEPARTMENT OF NATURAL RESOURCES

Bureau of Land and Water Resources

Southport Mall

P.O. Box 10631

Jackson, Mississippi 39209

WATER WELL DRILLERS LOG

Jackson
J 2155

11-29-83

Coast Water Well Sew. Jackson

date well completed

firm name

county well located

LANDOWNER:

Shud Jayan

description of formations encountered

from

to

10110 Jim Ramsey Rd

Top soil

0 3'

Ocean Springs, Miss (mailing address) 39564

R. Clay

3' 27'

WELL LOCATION:

sec. 3 T. 66 R. 8

M. Sand

27' 90'

5 miles UNW of VINCLAKE (distance) (direction) (nearest town)

S Clay

90' 112'

WELL PURPOSE: Home (home, irrigation, municipal, industrial)

C. Sand

112' 165'

WELL COMPLETION DATA:

(1) diameter (inches) 2"

(2) total depth (feet) 165'

(3) static water level (feet) 25' below top of ground

(4) casing PVC 155' (material) (depth)

2" (size) if telescope see back.

(5) screen 10' 155' (length) (depth to top)

2" PVC (size) (material)

(6) pump 1 h.p. 10 (HP) (yield gpm)

Electric (type power)

(7) electric log No. (yes or no)

(organization running log)

(8) how well bottom plugged back wash valve

DRILLERS REMARKS:


DEPT. OF NATURAL RESOURCES BUREAU OF LAND & WATER RESOURCES

MAR - 1 1984

RECEIVED

If well telescopes please sketch and show depths.

GROUND LEVEL

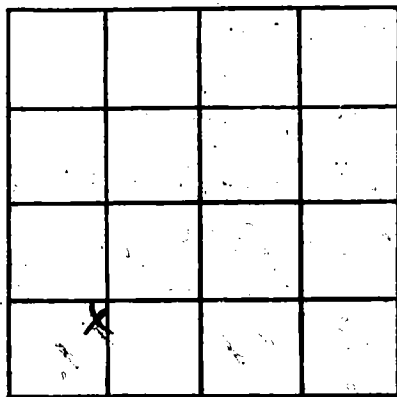

SECTION 3

Please indicate well location X.

ADDITIONAL INFORMATION

If more than one screen, show locations of each on sketch.