

MISSISSIPPI DEPARTMENT OF NATURAL RESOURCES

Bureau of Land and Water Resources

Southport Mall

P.O. Box 10631

Jackson, Mississippi 39209

WATER WELL DRILLERS LOG

Jackson  
82157

Jan. 3. 1984, Coast Water Well Serv. Jackson  
date well completed firm name county well located

LANDOWNER: Raymond M...  
Rt 6-Box 358  
Ocean Springs, Miss.  
(mailing address) 39564

description of formations encountered	from	to
Top soil	0	1'
Red Clay	1'	30'
Red Coarse sand	30'	126'
Red Clay & streak of sand	126'	172'
Blue Clay	172'	455'
Gray fine sand	455'	473'
Gray Coarse sand	473'	506'
Blue Clay & streak of sand	506'	516'
10" x 2" Tail Pipe		

WELL LOCATION:  
sec 12 T 6 S R 8 W  
3 miles W of VANCLAUVE  
(distance) (direction) (nearest town)

WELL PURPOSE: Home  
(home, irrigation, municipal, industrial)

WELL COMPLETION DATA:

- (1) diameter (inches) 2"
- (2) total depth (feet) 516'
- (3) static water level (feet) 98' below top of ground
- (4) casing PVC, 506' (material) (depth)  
2" (size) If telescope see back.
- (5) screen 10' (length), 506' (depth to top)  
2" (size), PVC (material)
- (6) pump (HP) (yield gpm)  
(type power)
- (7) electric log No. (yes or no)  
(organization running log)

(8) How well bottom plugged  
Backwash valve

DRILLERS REMARKS:


DEPT. OF NATURAL RESOURCES  
BUREAU OF LAND & WATER RESOURCES

MAR - 1 1984

RECEIVED

If well telescopes please sketch and show depths.

GROUND LEVEL

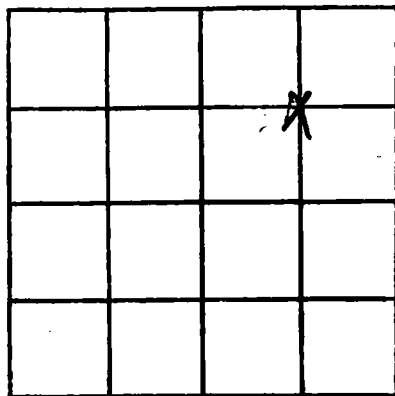

SECTION 12

Please indicate well location X.

ADDITIONAL INFORMATION

If more than one screen, show locations of each on sketch.