

MISSISSIPPI DEPARTMENT OF NATURAL RESOURCES

Bureau of Land and Water Resources

Southport Mall

P.O. Box 10631

Jackson, Mississippi 39209

WATER DRILLING & SERVICE LOG

ROUTE 1 BOX 618

BILOXI, MISS. 39532

Jackson
82158

5/5/78

date well completed

19

Jackson
county well located

LANDOWNER: Mr. Beta
Creek Road
Bellet MS
(mailing address)

description of formations encountered	from	to
<u>Top Soil</u>	<u>1</u>	<u>3</u>
<u>Red Clay</u>	<u>3</u>	<u>16</u>
<u>Sugar Sand</u>	<u>16</u>	<u>30</u>
<u>Orange white sand</u>	<u>30</u>	<u>45</u>
<u>Soft Blue Clay</u>	<u>45</u>	<u>310</u>
<u>Hard Blue Clay</u>	<u>310</u>	<u>390</u>
<u>fine white sand</u>	<u>390</u>	<u>420</u>
<u>Dark white sand</u>	<u>420</u>	<u>420</u>

WELL LOCATION:
sec 34 T 6 S R 9 W
Area A
(distance) (direction) of (nearest town)

WELL PURPOSE: None
(home, irrigation, municipal, industrial)

- WELL COMPLETION DATA:
- (1) diameter (Inches) 2"
 - (2) total depth (feet) 420'
 - (3) static water level (feet) 45' below above top of ground.
 - (4) casing PVC, 410'
(material) (depth)
(size) if telescope see back.
 - (5) screen 10', 410'
(length) (depth to top)
2"
(size) (material) PVC
 - (6) pump None 10
(HP) (yield gpm)
5hp
(type power)
 - (7) electric log No
(yes or no)
(organization running log)
 - (8) how well bottom plugged 2" back wash valve
1978

DRILLERS REMARKS:


MISSISSIPPI DEPARTMENT OF NATURAL RESOURCES
BUREAU OF LAND AND WATER RESOURCES

JUL - 2 1978

RECEIVED

If well telescopes please sketch and show depths.

GROUND LEVEL

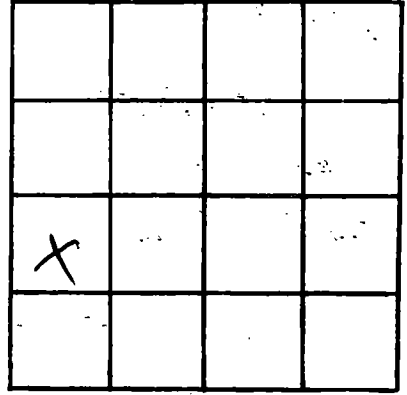

SECTION _____

Please indicate well location X.

ADDITIONAL INFORMATION

If more than one screen, show locations of each on sketch.