

MISSISSIPPI DEPARTMENT OF NATURAL RESOURCES

Bureau of Land and Water Resources

Southport Mall

P.O. Box 10631

Jackson, Mississippi 39209

WATER WELL DRILLERS LOG  
COASTAL DRILLING & SERVICE CO.

ROUTE 1 BOX 618

firm name  
BILOXI, MISS. 39532

county well located

Jackson  
82150

11/4/83 19  
date well completed

LANDOWNER: A.P. Odum

pt 6  
Ocean Springs  
(mailing address)

WELL LOCATION:

sec. 14 T. 6 S. R. 8 W.  
1/2 mile (distance) W (direction) of nearest town

WELL PURPOSE:

(home, irrigation, municipal, industrial)

WELL COMPLETION DATA:

(1) diameter (inches) 2"  
(2) total depth (feet) 380'  
(3) static water level (feet) 45' below top of ground.

(4) casing PC 370'  
(material) (depth)  
(size) if telescope see back.

(5) screen 10' 370'  
(length) (depth to top)  
2" PC  
(size) (material)

(6) pump 1/2 10  
(HP) (yield gpm)  
ele  
(type power)

(7) electric log no  
(yes or no)  
(organization running log)

(8) how well bottom plugged  
2" backwash valve  
DRILLERS REMARKS: -19-B

description of formations encountered

from to

top soil	1	3
Red Clay	3	18
White Sand	18	40
Soft Blue Clay	40	280
hard Blue Clay	280	340
fine white sand	340	360
good water sand	360	380

DEPT. OF NATURAL RESOURCES  
BUREAU OF LAND & WATER RESOURCES


JUN 29 1984

RECEIVED

If well telescopes please sketch and show depths.

GROUND LEVEL

*Handwritten notes and sketches, including a vertical line and various scribbles.*

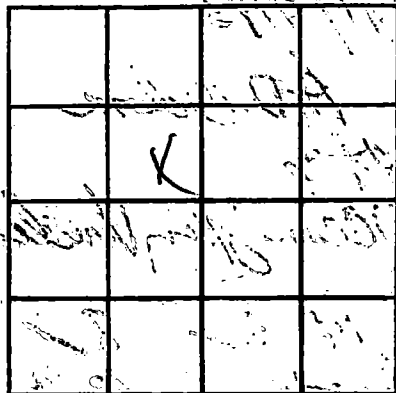

SECTION \_\_\_\_\_

Please indicate well location X.

**ADDITIONAL INFORMATION**

*Multiple horizontal lines with handwritten notes, including the word 'LOSS' and other illegible text.*

If more than one screen, show locations of each on sketch.