

MISSISSIPPI DEPARTMENT OF NATURAL RESOURCES

Bureau of Land and Water Resources

Southport Mall

P.O. Box 10631

Jackson, Mississippi 39209

WATER WELL DRILLERS LOG

JACKSON
J 2163

5-29-84 19 Coast Water Well Serv. Jackson
date well completed firm name county well located

LANDOWNER: Area Jones

description of formations encountered

from to

Vanderve

Red sand

0 8'

Miss. 39564
(mailing address)

Red clay

8' 30'

WELL LOCATION:

sec 27 T 6 R 8
7 1/2 miles SW of Vanderve
(distance) (direction) (nearest town)

Red sand

30' 73'

WELL PURPOSE: Home
(home, irrigation, municipal, industrial)

WELL COMPLETION DATA:

(1) diameter (inches) 2"
(2) total depth (feet) 73
(3) static water level (feet) 13' below above top of ground.

(4) casing Pvc 63'
(material) (depth)

3"
(size) if telescope see back.

(5) screen 10' 63'
(length) (depth to top)

3"
(size) (material)

(6) pump _____
(HP) (yield gpm)

(type power)

(7) electric log No.
(yes or no)

(organization running log)

(8) how well bottom plugged
Back Wash Valve

DRILLERS REMARKS:


DEPT. OF NATURAL RESOURCES
BUREAU OF LAND & WATER RESOURCES

JUL 10 1984

RECEIVED

If well telescopes please sketch and show depths.

GROUND LEVEL

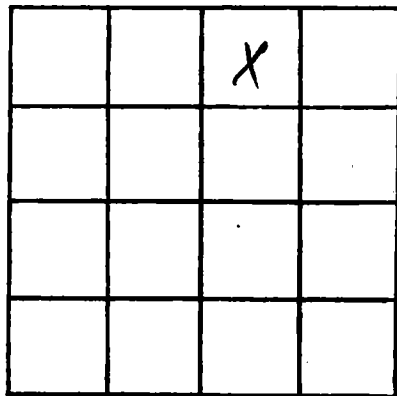

SECTION 27

Please indicate well location X.

ADDITIONAL INFORMATION

If more than one screen, show locations of each on sketch.