

MISSISSIPPI DEPARTMENT OF NATURAL RESOURCES

Bureau of Land and Water Resources

Southport Mall

P.O. Box 10631

Jackson, Mississippi 39209

WATER WELL DRILLERS LOG

Jackson
J2166

7-12-84 19 Coast Water Well Sew. Jackson
date well completed firm name county well located

LANDOWNER: Randy Smith
401 Begonia St.
Bilboe, Miss. 39531
(mailing address)

WELL LOCATION:
sec. 35 T. 6 N. R. 9 E
5 miles NNW of Ocean Springs
(distance) (direction) (nearest town)

WELL PURPOSE: Home
(home, irrigation, municipal, industrial)

WELL COMPLETION DATA:
(1) diameter (inches) 2"
(2) total depth (feet) 418'
(3) static water level (feet) 83' below ~~depth~~ top of ground.
(4) casing PVC, 408'
(material) (depth)
2" If telescope see back.
(size)
(5) screen 10', 408'
(length) (depth to top)
2" PVC
(size) (material)
(6) pump 2 h.p., 8
(HP) (yield gpm)
elect.
(type power)
(7) electric log no
(yes or no)
Elect.
(organization running log)
(8) how well bottom plugged
back wash valve

description of formations encountered	from	to
Top soil	0	10'
Red Clay	10'	25'
White coarse sand	25'	48'
Blue Clay	48'	200'
Blue Clay & streaks of sand	200'	223'
Blue Clay	223'	240'
Blue Clay & streaks of sand	240'	254'
Blue Clay	254'	292'
Blue Clay & streaks of sand	292'	364'
gray coarse sand	364'	408'
gray coarse sand (streaks of blue clay)	408'	418'
10'-2" Tail Pipe		

DEPT. OF NATURAL RESOURCES
BUREAU OF LAND & WATER RESOURCES


OCT 11 1984

RECEIVED

DRILLERS REMARKS:

If well telescopes please sketch and show depths.

GROUND LEVEL

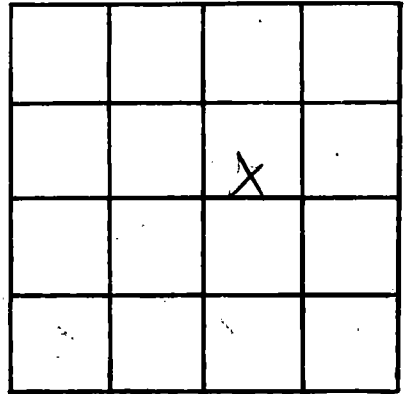

SECTION 35

Please indicate well location X.

ADDITIONAL INFORMATION

If more than one screen, show locations of each on sketch.