

MISSISSIPPI DEPARTMENT OF NATURAL RESOURCES
Bureau of Land and Water Resources
 Southport Mall
 P.O. Box 10631
 Jackson, Mississippi 39209
WATER WELL DRILLERS LOG

Jackson
82168

8.23 1984 Coast Water Well Sw Jackson
 date well completed firm name county well located

LANDOWNER:	description of formations encountered	from	to
<u>Crawford Dorman</u>	<u>Top Soil</u>	<u>0</u>	<u>7</u>
<u>P.O. Box 198</u>	<u>Gray Clay</u>	<u>7</u>	<u>15</u>
<u>Ocean Springs, MS</u> (mailing address) <u>39564</u>	<u>Coarse Sand</u>	<u>15</u>	<u>59</u>
WELL LOCATION:	<u>Blue Clay</u>	<u>59</u>	<u>120</u>
sec <u>36</u> T <u>6</u> S R <u>8</u> W	<u>Med Sand</u>	<u>120</u>	<u>159</u>
<u>5</u> miles <u>SW</u> of <u>Vanclave</u>	<u>Blue Clay + Sand</u>	<u>159</u>	<u>179</u>
(distance) (direction) (nearest town)	<u>Blue Clay</u>	<u>179</u>	<u>195</u>
WELL PURPOSE: <u>home</u> (home, irrigation, municipal, industrial)	<u>Fine Sand</u>	<u>195</u>	<u>220</u>
WELL COMPLETION DATA:	<u>Blue Clay</u>	<u>220</u>	<u>323</u>
(1) diameter (inches) <u>2"</u>	<u>Coarse Sand</u>	<u>323</u>	<u>360</u>
(2) total depth (feet) <u>360'</u>			
(3) static water level (feet) <u>60'</u> <u>below</u> top of ground			
(4) casing <u>PVC</u> <u>340'</u> (material) (depth)			
<u>2"</u> (size) if telescope see back.			
(5) screen <u>10'</u> <u>340'</u> (length) (depth to top)			
<u>2"</u> <u>PVC</u> (size) (material)			
(6) pump <u>1</u> <u>8</u> (HP) (yield gpm)			
<u>elec</u> (type power)			
(7) electric log <u>No</u> (yes or no)			
(organization running log)			
(8) how well bottom plugged <u>backwash valve</u>			

10' x 2" PVC Tail Pipe


DEPT. OF NATURAL RESOURCES
 BUREAU OF LAND & WATER RESOURCES

RECEIVED
 OCT 12 1984

DRILLERS REMARKS:

If well telescopes please sketch and show depths.

GROUND LEVEL

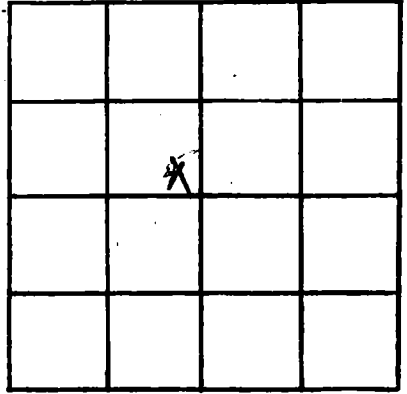

SECTION 36

Please indicate well location X.

ADDITIONAL INFORMATION

If more than one screen, show locations of each on sketch.