

MISSISSIPPI DEPARTMENT OF NATURAL RESOURCES
Bureau of Land and Water Resources
 Southport Mall
 P.O. Box 10631
 Jackson, Mississippi 39209
WATER WELL DRILLERS LOG

Jackson
22169

9-4-84 19 Coast Water Well Sew. Jackson
 date well completed firm name county well located

LANDOWNER: Bill Barton
Rt 4 - Box 204
Ocean Springs, Miss.
 (mailing address) 37564

WELL LOCATION:
 sec 14 T 6 R 8
4 1/2 miles SE of Vandeventer
 (distance) (direction) (nearest town)

WELL PURPOSE: home
 (home, irrigation, municipal, industrial)

WELL COMPLETION DATA:
 (1) diameter (inches) 2"
 (2) total depth (feet) 528'
 (3) static water level (feet) 75' below above top of ground.
 (4) casing PVC, 518'
 (material) (depth)
2" If telescope see back.
 (size)
 (5) screen 10', 518'
 (length) (depth to top)
2" PVC
 (size) (material)
 (6) pump 1/2 5
 (HP) (yield gpm)
Electric
 (type power)
 (7) electric log No
 (yes or no)
 (organization running log)
 (8) how well bottom plugged back with talcum

description of formations encountered	from	to
Top soil	0	6'
Red Clay	6'	23'
Red coarse sand & wood	23'	75'
Blue Clay & wood	75'	107'
Blue Clay	107'	150'
Red coarse sand	150'	172'
Blue Clay & wood	172'	290'
Blue Clay & streak of sand	290'	322'
Blue Clay	322'	375'
Blue Clay & cypress tree	375'	440'
Blue Clay	440'	455'
Blue Clay & streak of sand	455'	480'
gray coarse sand	480'	518'
Blue Clay	518'	528'
10' - 2" Tail pipe		
Shale Patched		

DEPT. OF NATURAL RESOURCES
 BUREAU OF LAND & WATER


OCT 12 1984

RECEIVED

DRILLERS REMARKS:

If well telescopes please sketch and show depths.

GROUND LEVEL

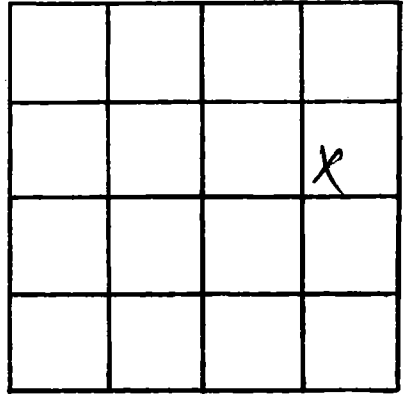

SECTION 14

Please indicate well location X.

ADDITIONAL INFORMATION

Lined area for additional information.

If more than one screen, show locations of each on sketch.