

MISSISSIPPI DEPARTMENT OF NATURAL RESOURCES

Bureau of Land and Water Resources

Southport Mall

P.O. Box 10631

Jackson, Mississippi 39209

WATER WELL DRILLERS LOG

Jackson
J 2181

9/13 date well completed
84 Braden Pump & Well Serv. Inc. firm name
Jackson county well located

LANDOWNER: Chas. B. Tolson
10704 Tucker Rd.
Ocean Springs, Ms. 39564
(mailing address)

description of formations encountered	from	to
Clay + sand	0	20
gray clay	20	40
blue clay	40	60
Clay + sandy	60	75
Clay + sand	75	135
Clay	135	155
Clay + sand	155	170
sand	170	190

WELL LOCATION:
sect 26.6 R 9
3 miles So. of Lakeland
(distance) (direction) (nearest town)

WELL PURPOSE: Home
(home, irrigation, municipal, industrial)

WELL COMPLETION DATA:
(1) diameter (Inches) 4"
(2) total depth (feet) 190'
(3) static water level (feet) 40' below ground top of ground.
(4) casing PVC, 160'
(material) (depth)
4" If telescope see back.
(size)
(5) screen 20', 160'
(length) (depth to top)
4", PVC underbar
(size) (material)
(6) pump 1 (HP) (yield gpm)
230 V
(type power)
(7) electric log NO
(yes or no)

(organization running log) PVC sandshark
(8) how well bottom plugged

DRILLERS REMARKS: 10' tailpipe


DEPT. OF NATURAL RESOURCES
BUREAU OF LAND & WATER RESOURCES

OCT 22 1984

RECEIVED

If well telescopes please sketch and show depths.

GROUND LEVEL

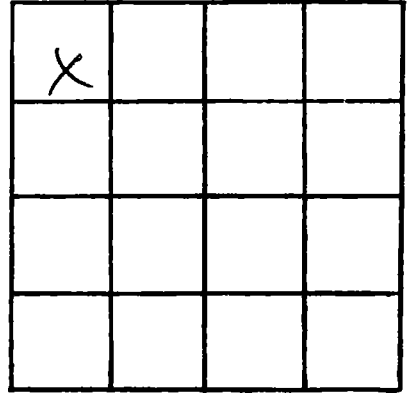

SECTION 26

Please indicate well location X.

ADDITIONAL INFORMATION

If more than one screen, show locations of each on sketch.