

**MISSISSIPPI DEPARTMENT OF NATURAL RESOURCES**  
**Bureau of Land and Water Resources**  
 Southport Mall  
 P.O. Box 10631  
 Jackson, Mississippi 39209  
**WATER WELL DRILLERS LOG**

Jackson  
8 2182

6/1 1984 Exfoyle Water Well Jackson  
 date well completed firm name county well located

LANDOWNER: H.L. Harvey

description of formations encountered	from	to
---------------------------------------	------	----

Vanclave, MS  
 (mailing address)

<u>Topsoil &amp; Sand</u>	<u>0</u>	<u>20</u>
<u>SAND</u>	<u>30</u>	<u>60</u>
<u>CLAY</u>	<u>80</u>	<u>105</u>
<u>SAND</u>	<u>105</u>	<u>178</u>
<u>CLAY</u>	<u>178</u>	<u>180</u>
<u>SAND</u>	<u>180</u>	<u>190</u>

WELL LOCATION:  
 sec. 35 T 6 N R 8 E  
10 miles SW of VANCLAVE  
 (distance) (direction) (nearest town)

WELL PURPOSE: Home  
 (home, irrigation, municipal, industrial)

WELL COMPLETION DATA:

- (1) diameter (inches) 2"
- (2) total depth (feet) 190
- (3) static water level (feet) 6" below top of ground
- (4) casing PVC, 190'  
 (material) (depth)  
2"  
 (size) If telescope see back.
- (5) screen 10', 180'  
 (length) (depth to top)  
#8, PVC  
 (size) (material)
- (6) pump 1, 15  
 (HP) (yield gpm)  
Elec  
 (type power)
- (7) electric log NO  
 (yes or no)

(organization running log)

(8) how well bottom plugged good


DRILLERS REMARKS:

COPY OF NATURAL RESOURCES  
 BUREAU OF LAND & WATER RESOURCES

JUN 28 1984  
**RECEIVED**

If well telescopes please sketch and show depths.

GROUND LEVEL

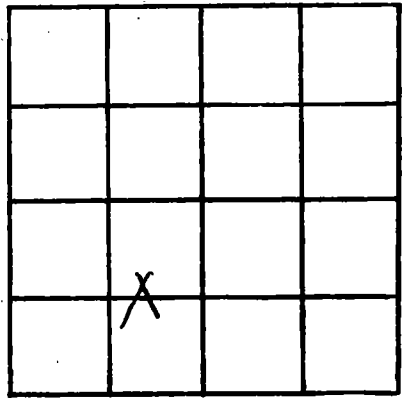

SECTION 4

Please indicate well location X.

ADDITIONAL INFORMATION

If more than one screen, show locations of each on sketch.