

MISSISSIPPI DEPARTMENT OF NATURAL RESOURCES

Bureau of Land and Water Resources

Southport Mall

P.O. Box 10631

Jackson, Mississippi 39209

WATER WELL DRILLERS LOG

Jackson
J 2183

10-8-85 date well completed 84 Coast Water Well Sew. firm name Jackson county well located

LANDOWNER: Ron Lygate
Rt 1, Box 59
Ocean Springs, Miss.
(mailing address) 37564

WELL LOCATION:
sec. 18 T. 6 S. R. 8 E.
7 miles N of Ocean Springs
(distance) (direction) (nearest town)

description of formations encountered	from	to
Blue Clay	0	144'
White sand	144'	193'
Blue Clay	193'	260'
White sand	260'	278'
Blue Clay	278'	365'
Sand-fine to coarse	365'	457'

WELL PURPOSE: Home
(home, irrigation, municipal, industrial)

WELL COMPLETION DATA:

(1) diameter (inches) 2"

(2) total depth (feet) 457'

(3) static water level (feet) 45' below above top of ground.

(4) casing PVC 447' (material) (depth)
2" (size) if telescope see back.

(5) screen 10' 447' (length) (depth to top)
2" (size) PVC (material)

(6) pump 1 8 (HP) (yield gpm)
(type power)

(7) electric log No (yes or no)
(organization running log)

(8) how well bottom plugged
Back wash valve


5 ft. Tail Pipe

1-8-85
LAW

DRILLERS REMARKS:

If well telescopes please sketch and show depths.

GROUND LEVEL

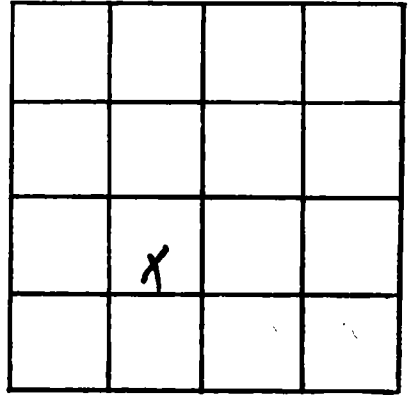

SECTION 18

Please indicate well location X.

ADDITIONAL INFORMATION

If more than one screen,
show locations of each on sketch.