

MISSISSIPPI DEPARTMENT OF NATURAL RESOURCES

Bureau of Land and Water Resources

Southport Mall

P.O. Box 10631

Jackson, Mississippi 39209

WATER WELL DRILLERS LOG

Jackson
J 2184

10-29-84
date well completed

Coast Water Well Sew.
firm name

Jackson
county well located

LANDOWNER:

Galanda Moore

description of formations encountered

from

to

8309 Southern Parkway
Ocean Springs, Miss.
(mailing address) 33524

Red Clay

0 20'

Med. Sand

20' 75'

WELL LOCATION:

sec. 24 T. 6 R. 8
4 miles SE of VAN CLEAVE
(distance) (direction) (nearest town)

5 ft 2" Tail Pipe

WELL PURPOSE:

None
(home, irrigation, municipal, industrial)

WELL COMPLETION DATA:

- (1) diameter (inches) 2"
- (2) total depth (feet) 75'
- (3) static water level (feet) 24' below above top of ground.
- (4) casing PVC, 65'
(material) (depth)
2" if telescope see back.
(size)
- (5) screen 10', 65'
(length) (depth to top)
2", PVC
(size) (material)
- (6) pump 1/2 h.p., 6 1/2
(HP) (yield gpm)
Elect.
(type power)
- (7) electric log No.
(yes or no)

(organization running log)


(8) back well bottom plugged
Back Wash Valve

1-8-85
JCW

DRILLERS REMARKS:

If well telescopes please sketch and show depths.

GROUND LEVEL

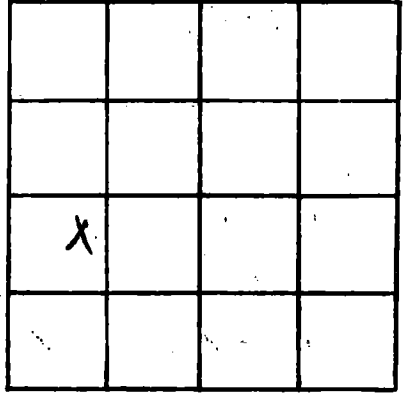

SECTION

24

Please indicate well location X.

ADDITIONAL INFORMATION

If more than one screen, show locations of each on sketch.