

MISSISSIPPI DEPARTMENT OF NATURAL RESOURCES

Bureau of Land and Water Resources

Southport Mall

P.O. Box 10631

Jackson, Mississippi 39209

WATER WELL DRILLERS LOG

COASTAL DRILLING & SERVICE CO.

Jackson

JACKSON
J 2189

12/12/84 19
date well completed

Bl. 1111 81

county well located

LANDOWNER: D. Summers

BL 1111

RD 37557

description of formations encountered

from

to

Duttons city

top soil

1

3

Ocean Springs
(mailing address)

sluggish sand

3

10

red clay

10

140

hard blue clay

140

210

fine water sand

210

220

loose water sand

220

230

WELL LOCATION:

sec. 20 T. 6 N. R. 8 E.

Ocean Springs miles

(distance) (direction) (nearest town)

WELL PURPOSE: home
(home, irrigation, municipal, industrial)

WELL COMPLETION DATA:

(1) diameter (inches) 2"

(2) total depth (feet) 230'

(3) static water level (feet) 10' below top of ground.

(4) casing PVC, 220'
(material) (depth)

(size) if telescope see back.

(5) screen 10', 220'
(length) (depth to top)

2", PVC
(size) (material)

(6) pump 1, 179
(HP) (yield gpm)

etc.
(type power)

(7) electric log No
(yes or no)

(organization running log)

(8) how well bottom plugged 2" back washalix 19-8

DRILLERS REMARKS:


RECEIVED

AUG - 5 1985

Department of Natural Resources
Bureau of Land & Water Resources

If well telescopes please sketch and show depths.

GROUND LEVEL

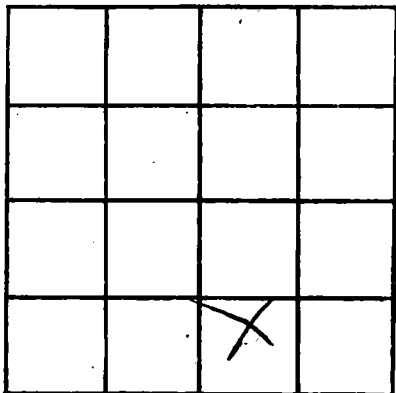

SECTION _____

Please indicate well location X.

ADDITIONAL INFORMATION

If more than one screen,
show locations of each on sketch.