

MISSISSIPPI DEPARTMENT OF NATURAL RESOURCES

Bureau of Land and Water Resources

Southport Mall

P.O. Box 10631

Jackson, Mississippi 39209

WATER WELL DRILLERS LOG

J 2190
JACKSON
12-17-84

12-17-84
date well completed

Trujillo Well Serv.
firm name

Jackson
county well located

LANDOWNER: John Willey
16300 Pea Patch Rd
Biloxi, MS 39532
(mailing address)

description of formations encountered	from	to
top soil	0	20
Clay	20	40
Clay	40	65
Sandy Clay	60	80
hd. Sandstone	80	130
Sand + Clay	130	200
Clay	200	220
Sand	220	240

WELL LOCATION:
sec 26 T 6 N R 9 E
6 miles (distance) NW of Ocean Springs (nearest town)

WELL PURPOSE:
(home, irrigation, municipal, industrial)

WELL COMPLETION DATA:
(1) diameter (inches) 2"
(2) total depth (feet) 240'
(3) static water level (feet) 100 below top of ground.
(4) casing PVC, 230 (depth)
(size) 10 If telescope see back.
(5) screen 90 (length), 230 (depth to top)
(size) 10, PVC (material)
(6) pump 5 (yield gpm)
(HP)
Elect (type power)
(7) electric log no (yes or no)
(organization running log)

Test Drilled for 240 ft.
Clay all the way.

(8) how well bottom plugged PVC Ball
Clay


RECEIVED
SEPT 17 1985

DRILLERS REMARKS:

Department of Natural Resources
Bureau of Land & Water Resources

If well telescopes please sketch and show depths.

GROUND LEVEL

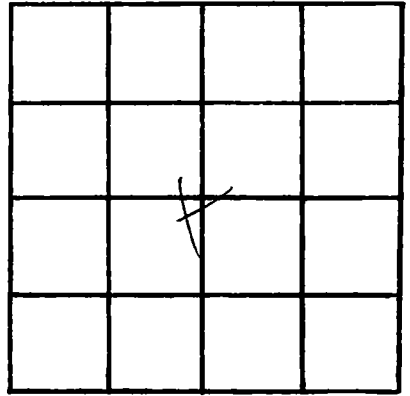

SECTION 4

Please indicate well location X.

ADDITIONAL INFORMATION

If more than one screen, show locations of each on sketch.