

JACKSON
52191

MISSISSIPPI DEPARTMENT OF NATURAL RESOURCES
Bureau of Land and Water Resources
Southport Mall
P.O. Box 10631
Jackson, Mississippi 39209
WATER WELL DRILLERS LOG

3-19-85 19 Coast Water Well Serv. Inc. Jackson
date well completed firm name county well located

LANDOWNER: Michael Williams
Seamon Road
Ocean Springs, Miss.
(mailing address) 39564

description of formations encountered	from	to
Top soil	0	2'
Red Clay	2'	15'
Sand (Strip Clay)	15'	190'
Blue Clay (clay sand)	190'	255'
fine sand	255'	265'

WELL LOCATION:
sec. 14 T. 6 N. R. 8 W.
4 miles SW of Vardeane
(distance) (direction) (nearest town)

Blue Clay 265' 275'

WELL PURPOSE:
(home, irrigation, municipal, industrial)

WELL COMPLETION DATA:

(1) diameter (inches) 2"

Med. sand 275' 295'

(2) total depth (feet) 450'

Blue Clay-strip sand 295' 387'

(3) static water level (feet) 80' below
top of ground. above

Med. sand 387' 409'

(4) casing PVC 430'
(material) (depth)

Coarse pebbly sand 409' 450'

2"
(size) if telescope see back.

5'-2" PVC Tail Pipe

(5) screen 20' 430'
(length) (depth to top)

2" PVC
(size) (material)

(6) pump 1 1/2 well
(HP) (yield gpm)

Elect.
(type power)

(7) electric log no
(yes or no)

(organization running log)

(8) how well bottom plugged.
Backwash Valve

DRILLERS REMARKS:


RECEIVED

JUL 10 1985

Department of Natural Resources
Bureau of Land & Water Resources

If well telescopes please sketch and show depths.

GROUND LEVEL

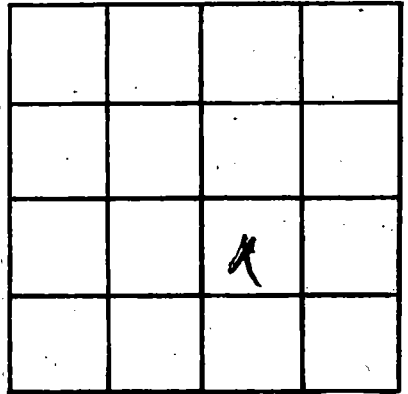

SECTION

14

Please indicate well location X.

ADDITIONAL INFORMATION

If more than one screen, show locations of each on sketch.