

JACKSON  
52192

MISSISSIPPI DEPARTMENT OF NATURAL RESOURCES  
Bureau of Land and Water Resources  
Southport Mall  
P.O. Box 10631  
Jackson, Mississippi 39209  
WATER WELL DRILLERS LOG

4-9-85 19 Coast Water Well Sew. Jackson  
Date well completed firm name county well located

LANDOWNER: George Jones  
1338.3 Pine Ave  
Ocean Springs, Miss.  
(mailing address) 33164

description of formations encountered	from	to
<u>Red Clay</u>	<u>0</u>	<u>21'</u>
<u>White coarse sand</u>	<u>21'</u>	<u>45'</u>
<u>Blue Clay</u>	<u>45'</u>	<u>215'</u>
<u>Blue Clay slip sand</u>	<u>300'</u>	<u>322'</u>

WELL LOCATION:  
sec. 25 T. 6 R. 9  
5 miles NW of OCEAN SPRINGS  
(distance) (direction) (nearest town)

WELL PURPOSE: Home  
(home, irrigation, municipal, industrial)

WELL COMPLETION DATA:

- (1) diameter (inches) 2"
- (2) total depth (feet) 322'
- (3) static water level (feet) 35' below above top of ground.
- (4) casing PVC 302'  
(material) (depth)  
2" if telescope see back.  
(size)
- (5) screen 20' 302'  
(length) (depth to top)  
2" PVC  
(size) (material)
- (6) pump \_\_\_\_\_ (HP) \_\_\_\_\_ (yield gpm)
- (7) electric log check  
(type power)
- (7) electric log No  
(yes or no)
- \_\_\_\_\_ (organization running log)

(8) how well bottom plugged  
Back Wash Valve


DRILLERS REMARKS:

RECEIVED  
JUL 10 1985

Department of Natural Resources  
Bureau of Land & Water Resources

If well telescopes please sketch and show depths.

GROUND LEVEL

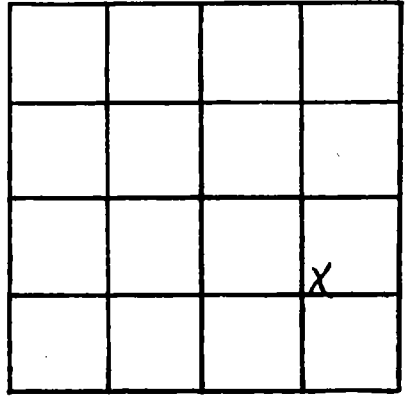

SECTION 25

Please indicate well location X.

ADDITIONAL INFORMATION

If more than one screen, show locations of each on sketch.