

Jackson
J 2193
5-1-85

MISSISSIPPI DEPARTMENT OF NATURAL RESOURCES
Bureau of Land and Water Resources
Southport Mall
P.O. Box 10631
Jackson, Mississippi 39209
WATER WELL DRILLERS LOG

L

5-1-85 19 Coast Water Well Sew. Jackson
date well completed firm name county well located

LANDOWNER: Robert Bakker
10701 Tucker Rd.
Biloxi, Miss.
(mailing address)

WELL LOCATION:
sec. 26 T. 6 N. R. 9 E.
6 miles NNW of Ocean Springs
(distance) (direction) (nearest town)

WELL PURPOSE: Home
(home, irrigation, municipal, industrial)

- WELL COMPLETION DATA:
- (1) diameter (inches) 2"
 - (2) total depth (feet) 156'
 - (3) static water level (feet) 68' below above top of ground
 - (4) casing PVC, 146'
(material) (depth)
2" if telescope see back.
(size)
 - (5) screen 10', 146'
(length) (depth to top)
2", PVC
(size) (material)
 - (6) pump 1 hp., 7 1/2
(HPI) (yield gpm)
Elect.
(type power)
 - (7) electric log No
(yes or no)

(organization running log)
 - (8) how well bottom plugged
Jack wash Talus

description of formations encountered	from	to
<u>Top soil</u>	<u>0</u>	<u>3'</u>
<u>Blue Clay</u>	<u>3'</u>	<u>45'</u>
<u>Blue Clay & (stuck) sand</u>	<u>45'</u>	<u>80'</u>
<u>Blue Clay</u>	<u>80'</u>	<u>146'</u>
<u>gray med. sand</u>	<u>146'</u>	<u>156'</u>


RECEIVED
JUL 11 1985

Department of Natural Resources
Bureau of Land & Water Resources

DRILLERS REMARKS:

If well telescopes please sketch and show depths.

GROUND LEVEL

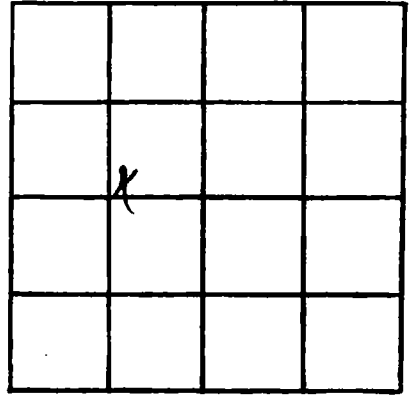

SECTION 26

Please indicate well location X.

ADDITIONAL INFORMATION

If more than one screen, show locations of each on sketch.