

JACKSON

52194

MISSISSIPPI DEPARTMENT OF NATURAL RESOURCES

Bureau of Land and Water Resources

Southport Mall

P.O. Box 10631

Jackson, Mississippi 39209

WATER WELL DRILLERS LOG

5-25-85
date well completed

Cross Water Well Sew.
firm name

Jackson
county well located

LANDOWNER: George Mullins

10706 Tucker Road

Ocean Springs, Miss.
(mailing address) 39564

WELL LOCATION:

sec 26 T 6 N R 9 E
2 miles (distance) S (direction) of LATIMER (nearest town)

WELL PURPOSE: Home
(home, irrigation, municipal, industrial)

WELL COMPLETION DATA:

- (1) diameter (inches) 2"
- (2) total depth (feet) 330'
- (3) static water level (feet) 125' below top of ground.
- (4) casing PVC 320' (material) (depth)
2" (size) if telescope see back.
- (5) screen 10' 320' (length) (depth to top)
2" PVC (size) (material)
- (6) pump (HP) (yield gpm)
Electric (type power)
- (7) electric log No (yes or no)
- (organization running log)
- (8) how well bottom plugged
Backwash Valve


description of formations encountered	from	to
Top soil	0	5'
Red Clay	5'	15'
Gray Clay	15'	27'
Blue Clay	27'	110'
Blue Clay & streak of sand	110'	125'
Blue Clay	125'	298'
Gray med sand	298'	325'
Blue Clay	325'	330'

RECEIVED
JUL 10 1985

DRILLERS REMARKS:

If well telescopes please sketch and show depths.

GROUND LEVEL

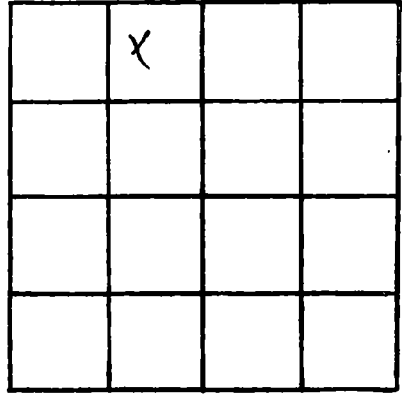

SECTION 26

Please indicate well location X.

ADDITIONAL INFORMATION

Lined area for additional information.

If more than one screen, show locations of each on sketch.