

MISSISSIPPI DEPARTMENT OF NATURAL RESOURCES

Bureau of Land and Water Resources

Southport Mall

P.O. Box 10631

Jackson, Mississippi 39209

WATER WELL DRILLERS LOG

Jackson  
J 2195

6-14-85 19  
date well completed

Coast Water Well Sew. Jackson  
firm name county well located

LANDOWNER: George Beatty  
703 Ward Ave  
Ocean Springs, Miss.  
(mailing address) 39564

description of formations encountered	from	to
Top soil	0	2'
Blue Clay	2'	45'
Red coarse sand	45'	73'
Blue Clay	73'	75'
3" - 2" Tail Pipe		

WELL LOCATION:  
sec 36-T-6 R-8  
4 miles NE of OCEAN SPRINGS  
(distance) (direction) (nearest town)

WELL PURPOSE: Home  
(home, irrigation, municipal, industrial)

WELL COMPLETION DATA:

- (1) diameter (inches) 2"
  - (2) total depth (feet) 78'
  - (3) static water level (feet) 35' below top of ground.
  - (4) casing PVC, 68'  
(material) (depth)  
2" if telescope see back.  
(size)
  - (5) screen 10', 68'  
(length) (depth to top)  
2", PVC  
(size) (material)
  - (6) pump ~~HP~~, —  
(HP) (yield gpm)  
Elect.  
(type power)
  - (7) electric log no  
(yes or no)
- (organization running log)

(8) how well bottom plugged: Subsided Valve

DRILLERS REMARKS:


RECEIVED

NOV - 1 1985

Department of Natural Resources  
Bureau of Land & Water Resources

If well telescopes please sketch and show depths.

GROUND LEVEL

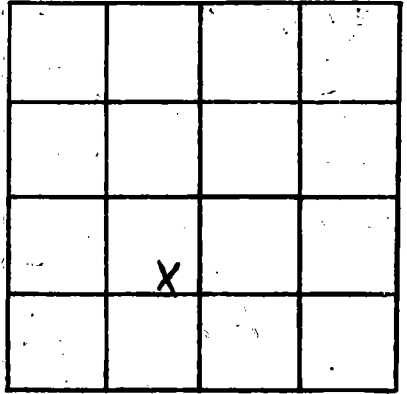

SECTION 36

Please indicate well location X.

ADDITIONAL INFORMATION

If more than one screen, show locations of each on sketch.