

MISSISSIPPI DEPARTMENT OF NATURAL RESOURCES

Bureau of Land and Water Resources

Southport Mall

P.O. Box 10631

Jackson, Mississippi 39209

WATER WELL DRILLERS LOG

JACKSON
J 2 197

7-23-85 19
date well completed

Coast Water Well
firm name

Jackson
county well located


LANDOWNER: Wesley R. Jones Jr
129129m Ramsey Rd
Ocean Springs, MO
(mailing address) 39564

description of formations encountered	from	to
Top Soil	0'	1'
Red Clay	1'	32'
Blue Clay	32'	146'
Blue Clay	146'	172'
Streak of Sand		
Blue Clay	172'	319'
Gray Coarse Sand	319'	378'

WELL LOCATION:
sec 18 T. 6 N. R. 8 W.
3 miles SE of LATIMER
(distance) (direction) (nearest town)

WELL PURPOSE: Home
(home, irrigation, municipal, industrial)

WELL COMPLETION DATA:
(1) diameter (inches) 4"
(2) total depth (feet) 378 ft
(3) static water level (feet) 54 below above top of ground.
(4) casing PVC 358
(material) (depth)
4" if telescope see back.
(size)
(5) screen 20' 358'
(length) (depth to top)
4" PVC
(size) (material)
(6) pump 1 20
(HP) (yield gpm)
eee
(type power)
(7) electric log no
(yes or no)
(organization running log)
(8) how well bottom plugged Backwash Valve

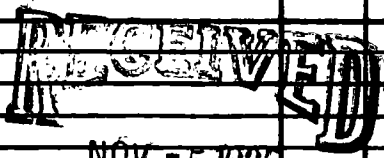


NOV - 5 1985

Department of Natural Resources
Bureau of Land & Water Resources

DRILLERS REMARKS:

If well telescopes please sketch and show depths.

GROUND LEVEL

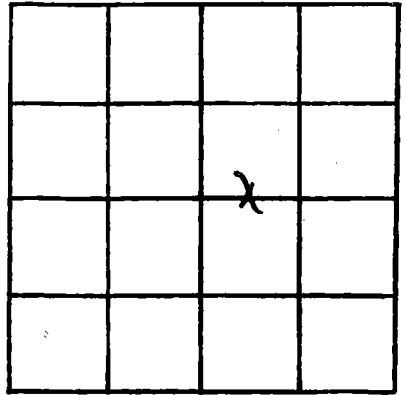

SECTION B

Please indicate well location X.

ADDITIONAL INFORMATION

If more than one screen, show locations of each on sketch.