

MISSISSIPPI DEPARTMENT OF NATURAL RESOURCES

Bureau of Land and Water Resources

Southport Mall

P.O. Box 10631

Jackson, Mississippi 39209

WATER WELL DRILLERS LOG

JACKSON  
J 2198

8-1-85 19 date well completed  
Coast Water Well Serv. Jackson firm name  
Jackson county well located

LANDOWNER: W. J. Linder  
4619 Gautier St.  
Miss Pointe Mer.  
(mailing address) 392163

WELL LOCATION:  
sec. 25 T 6 R 9  
5 miles N of OCEAN SPRINGS  
(distance) (direction) (nearest town)

WELL PURPOSE: Home  
(home, irrigation, municipal, industrial)

WELL COMPLETION DATA:  
(1) diameter (inches) 2"  
(2) total depth (feet) 210'  
(3) static water level (feet) 68' below above top of ground.  
(4) casing PVC, 205'  
(material) (depth)  
2" If telescope see back.  
(size)  
(5) screen 5', 205'  
(length) (depth to top)  
2", PVC  
(size) (material)  
(6) pump \_\_\_\_\_  
(HP) (yield gpm)  
(type power)  
(7) electric log No  
(yes or no)  
(organization running log)  
(8) how well bottom plugged  
Back Wash Valve

| description of formations encountered | from | to   |
|---------------------------------------|------|------|
| Top soil                              | 0    | 1'   |
| Red fine sand & silt                  | 1'   | 5'   |
| Red Clay                              | 5'   | 13'  |
| Blue Clay Shale Sand                  | 13'  | 55'  |
| Gray fine sand                        | 55'  | 65'  |
| Blue Clay                             | 65'  | 146' |
| Gray fine sand                        | 146' | 162' |
| Blue Clay                             | 162' | 185' |
| Gray Coarse sand                      | 185' | 192' |
| Blue Clay                             | 192' | 210' |


RECEIVED  
NOV - 1 1985

DRILLERS REMARKS:

Department of Natural Resources  
Bureau of Land & Water Resources

If well telescopes please sketch and show depths.

GROUND LEVEL

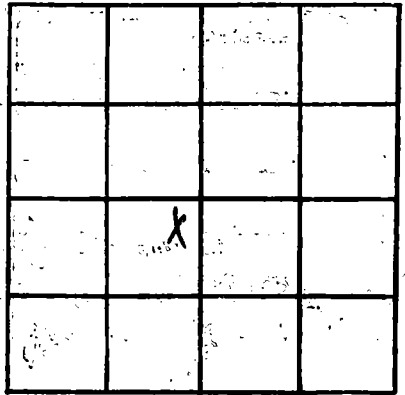

SECTION 25

Please indicate well location X:

ADDITIONAL INFORMATION

If more than one screen, show locations of each on sketch.