

MISSISSIPPI DEPARTMENT OF NATURAL RESOURCES

Bureau of Land and Water Resources

Southport Mall

P.O. Box 10631

Jackson, Mississippi 39209

WATER WELL DRILLERS LOG

Jackson
52201

10-11-85 19
date well completed

Coast Water Well Sew.
firm name

Jackson
county well located

LANDOWNER:

Mitch Tucker
P.O. Box 1432
Biloxi, Miss.
(mailing address) 39533

description of formations encountered

description of formations encountered	from	to
Top soil	0	2'
Blue Clay	2	14'
White Coarse sand	14'	38'
Blue Clay	38'	70'
Fine Gray sand	70'	90'
Blue Clay	90'	135'
Gray Coarse sand	135'	175'

WELL LOCATION:

sec 25 T 6 N R 9 E
6 miles N of OCEAN SPRINGS
(distance) (direction) (nearest town)

WELL PURPOSE:

(home, irrigation, municipal, industrial)
Home


WELL COMPLETION DATA:

- (1) diameter (inches) 2"
- (2) total depth (feet) 175'
- (3) static water level (feet) 26' below top of ground
- (4) casing PVC 160' (material) (depth)
2" (size) if telescope see back.
- (5) screen 10' 160' (length) (depth to top)
2" PVC (size) (material)
- (6) pump (HP) (yield gpm)
Blue (type power)
- (7) electric log No (yes or no)
- (organization running log)

(8) how well bottom plugged
Back Wash Valve

DRILLERS REMARKS:

5' Tail Pipe
Shed Catcher

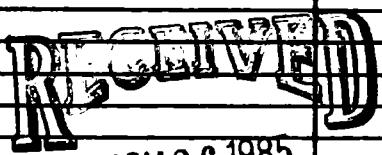


NOV 26 1985

Department of Natural Resources
Bureau of Land & Water Resources

If well telescopes please sketch and show depths.

GROUND LEVEL

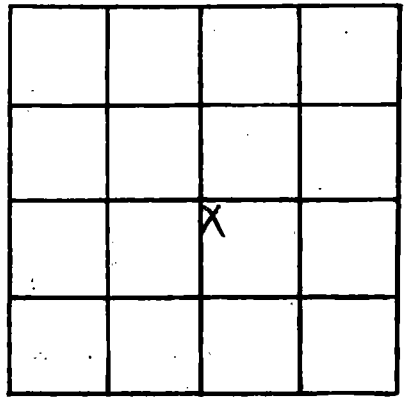

SECTION 25

Please indicate well location X.

ADDITIONAL INFORMATION

A series of horizontal lines for writing additional information, starting below the 'ADDITIONAL INFORMATION' header and extending to the bottom of the page.

If more than one screen, show locations of each on sketch.