

MISSISSIPPI DEPARTMENT OF NATURAL RESOURCES

Bureau of Land and Water Resources

Southport Mall

P.O. Box 10631

Jackson, Mississippi 39209

WATER WELL DRILLERS LOG

Jackson
 2002

11-11-85
 date well completed

Coast water well

firm name

Jackson
 county well located

LANDOWNER: Danny Holland

Description of formations encountered

from

to

1008 N. Hopkins Blvd

Top Soil

0' 2'

Biloxi, Ms. 39531
 (mailing address)

Blue Clay

2' 50'

WELL LOCATION:

sec. 30 T. 6 N. R. 8 W.
5 miles NORTH of Ocean Springs
 (distance) (direction) (nearest town)

White Coarse Sand

50' 70'

Blue Clay

70' 83'

WELL PURPOSE: home
 (home, irrigation, municipal, industrial)

White Coarse Sand

83' 104'

Blue Clay

104' 299'

WELL COMPLETION DATA:

(1) diameter (inches) 2"
 (2) total depth (feet) 451 ft
 (3) static water level (feet) 68 below above
 top of ground.

Gray med. Sand

299' 311'

Blue Clay

311' 410'

(4) casing PVC 436'
 (material) (depth)

Gray Coarse Sand

410' 448'

Gray Coarse Sand & Gravel

448' 451'

2" If telescope see back.
 (size)

(5) screen 10' 436'
 (length) (depth to top)

2" PVC
 (size) (material)

(6) pump _____
 (HP) (yield gpm)

_____ (type power)

(7) electric log no
 (yes or no)

_____ (organization running log)

(8) has well bottom plugged backwash valve

RECEIVED

JAN 02 1986


Department of Natural Resources
 Bureau of Land and Water Resources

DRILLERS REMARKS:

5 ft - 2" PVC tail pipe

If well telescopes please sketch and show depths.

GROUND LEVEL

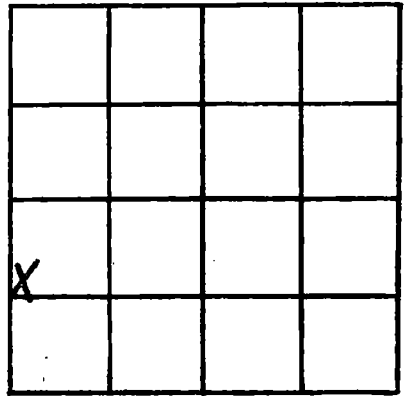

SECTION 30

Please indicate well location X.

ADDITIONAL INFORMATION

If more than one screen, show locations of each on sketch.