

MISSISSIPPI DEPARTMENT OF NATURAL RESOURCES

Bureau of Land and Water Resources

Southport Mall

P.O. Box 10631

Jackson, Mississippi 39209

WATER WELL DRILLERS LOG

JACKSON
T 2203

11-14-85

Coast Water Well Sew. Jackson

date well completed

firm name

county well located

LANDOWNER: Clarence Hartman

Vanderberg Hgts.

Biloxi, MS. 39530
(mailing address)

Description of formations encountered

from to

Top soil	0'	3'
Red Clay	3'	15'
Red Coarse sand	15'	40'
Red Clay	40'	57'
Blue Clay & Oyster Shell	57'	130'
Blue Clay	130'	190'
Blue Clay & Oyster Shell	190'	290'
Blue Clay & Shell Sand	290'	299'
Blue Clay	299'	350'
Blue Clay & Oyster Shell	350'	364'
Blue Clay	364'	453'
Blue fine sand & Oyster Shell	453'	475'
Blue fine sand	475'	514'
Gray Coarse sand	514'	534'
Blue Clay	534'	537'


WELL LOCATION:

sec 15 T 6 S R 9 W
10 0 2
IN miles (distance) of LATIMER (direction) (nearest town)

WELL PURPOSE: Home
(home, irrigation, municipal, industrial)

WELL COMPLETION DATA:

- (1) diameter (inches) 2"
- (2) total depth (feet) 537'
- (3) static water level (feet) 49' below top of ground
- (4) casing PVC, 523'
(material) (depth)
- 2" If telescope see back.
(size)
- (5) screen 10', 523'
(length) (depth to top)
- 2", PVC
(size) (material)
- (6) pump _____ (HP) _____ (yield gpm)
- _____ (type power)
- (7) electric log No
(yes or no)
- _____ (organization running log)
- (8) how well bottom plugged
Back Wash Valve

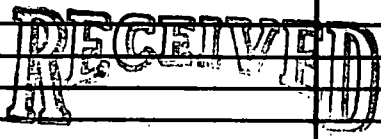

JAN 03 1986


DRILLERS REMARKS:

5' 2" Tail Pipe
Shoe Caught

Department of Natural Resources
Bureau of Land and Water Resources

If well telescopes please sketch and show depths.

GROUND LEVEL

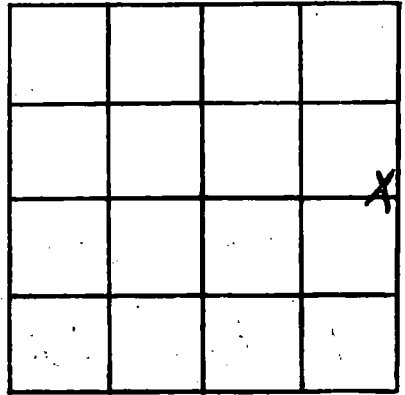

SECTION 15

Please indicate well location X.

ADDITIONAL INFORMATION

If more than one screen,
show locations of each on sketch.