

MISSISSIPPI DEPARTMENT OF NATURAL RESOURCES

Bureau of Land and Water Resources

Southport Mall

P.O. Box 10631

Jackson, Mississippi 39209

WATER WELL DRILLERS LOG

JACKSON  
J 2204

11-19-85

Coast Water Well Sew. Jackson

date well completed

firm name

county/well located

LANDOWNER:

Meryl Benton

description of formations encountered

from

to

325 Annets

Top soil

0

3'

Dyersville, Miss.  
(mailing address)

White Clay

3'

18'

WELL LOCATION:

sec. 34 T. 6 R. 9

Blue Clay

18'

65'

2 miles NORTH of DYERSVILLE  
(distance) (direction) (nearest town)

White Coarse Sand

65'

90'

WELL PURPOSE:

HOME

(home, irrigation, municipal, industrial)

Blue Clay

90'

239'

WELL COMPLETION DATA:

(1) diameter (inches) 2"

Gray fine sand

239'

260'

(2) total depth (feet) 279'

Gray Coarse Sand

260'

276'

(3) static water level (feet) 32' below top of ground

Blue Clay

276'

279'

(4) casing PVC, 264' (material) (depth)

2" (size) If telescope see back.

(5) screen 10' length, 264' depth to top

2" PVC (size) (material)

(6) pump 1 hp, 10 (type) (yield gpm)

Electric (type power)

(7) electric log No (yes or no)

(organization running log)

(8) how well bottom plugged  
Back wash valve

DRILLERS REMARKS:

5' 2" PVC Tail pipe  
Shoe Catcher


RECEIVED

JAN 03 1986

Department of Natural Resources  
Bureau of Land & Water Resources

If well telescopes please sketch and show depths.

GROUND LEVEL

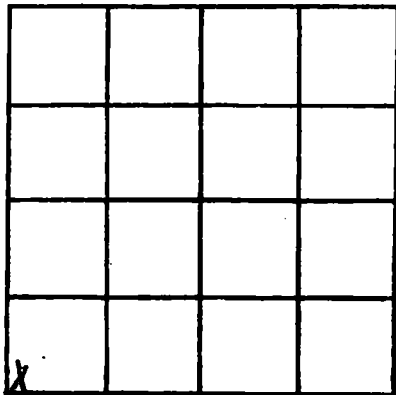

SECTION 34

Please indicate well location X.

ADDITIONAL INFORMATION

If more than one screen, show locations of each on sketch.