

MISSISSIPPI DEPARTMENT OF NATURAL RESOURCES

Bureau of Land and Water Resources

Southport Mall

P.O. Box 10631

Jackson, Mississippi 39209

WATER WELL DRILLERS LOG

Drexler
J 2807

12-14-85 19 Coast Water Well Sew. Jackson
date well completed firm name county well located

LANDOWNER: Michael Heise

description of formations encountered from to

Rt 2 - Box 280-1
North Biloxi, Ms.
(mailing address) 39532

<u>Top soil</u>	<u>0</u>	<u>1'</u>
<u>Brown Clay</u>	<u>1'</u>	<u>40"</u>
<u>Blue Clay</u>	<u>40'</u>	<u>342"</u>
<u>Gray med. sand</u>	<u>342'</u>	<u>365"</u>
<u>Blue Clay</u>	<u>365'</u>	<u>270"</u>

WELL LOCATION:
sec. 15 T. 6 N. R. 9 E
1 miles SE of LATIMER
(distance) (direction) (nearest town)

WELL PURPOSE: Home
(home, irrigation, municipal, industrial)

WELL COMPLETION DATA:

- (1) diameter (inches) 2"
- (2) total depth (feet) 270'
- (3) static water level (feet) 75' below top of ground.
- (4) casing PVC, 255'
(material) (depth)
- 2" if telescope see back.
(size)
- (5) screen 10', 255'
(length) (depth to top)
- 2", PVC
(size) (material)
- (6) pump 1/2 HP, 6
(HP) (yield gpm)
- Electric
(type power)
- (7) electric log No
(yes or no)

RECEIVED

FEB - 7 1986

Department of Natural Resources
Bureau of Land & Water Resources


(organization running log)

(8) how well bottom plugged Enc. Kwak Value

DRILLERS REMARKS:

If well telescopes please sketch and show depths.

GROUND LEVEL

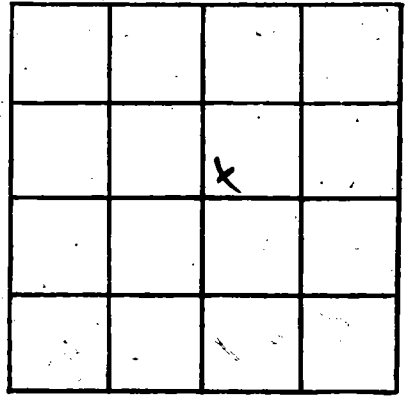

SECTION 15

Please indicate well location X.

ADDITIONAL INFORMATION

If more than one screen, show locations of each on sketch.