

MISSISSIPPI DEPARTMENT OF NATURAL RESOURCES

Bureau of Land and Water Resources

Southport Mall

P.O. Box 10631

Jackson, Mississippi 39209

WATER WELL DRILLERS LOG

GENERAL DRILLING & SERVICE CO.

~~Jackson~~  
JACKSON  
J 2208

12/10/85

date well completed

RT. 11, BOX 81

firm name

Jackson  
HARRISON  
county well located

BILOXI, MS 39532

LANDOWNER: Walley West

description of formations encountered

from

to

2346 Daisy West

top soil

1 3

season sand

3 45

red clay

45 200

blue clay

200 290

fine water sand

290 300

good water sand

300 310

Biloxi, MS

(mailing address)

WELL LOCATION:

sec. 35 T. 6 N. R. 9 W.

(5) (W)

Biloxi miles of (distance) (direction) (nearest town)

WELL PURPOSE: home  
(home, irrigation, municipal, industrial)

WELL COMPLETION DATA:

(1) diameter (inches) 2"

(2) total depth (feet) 310

(3) static water level (feet) 10 below above top of ground.

(4) casing PVC, 300  
(material) (depth)

(size) If telescope see back.

(5) screen 10', 300  
(length) (depth to top)

2", PVC  
(size) (material)

(6) pump 1 (HP) (yield gpm)

etc.  
(type power)

(7) electric log NO  
(yes or no)

(organization running log)

(8) how well bottom plugged 2" back  
wash (blue)

310  
-10  
-----  
300  
300  
+10  
-----  
310

RECEIVED


FEB 24 1986

DRILLERS REMARKS:

Department of Natural Resources  
Bureau of Land & Water Resources

If well telescopes please sketch and show depths.

GROUND LEVEL

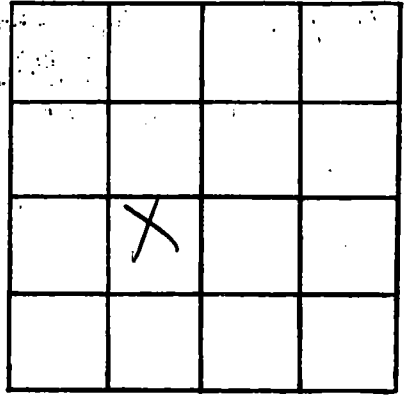

SECTION \_\_\_\_\_

Please indicate well location X.

ADDITIONAL INFORMATION

If more than one screen,  
show locations of each on sketch.