

MISSISSIPPI DEPARTMENT OF NATURAL RESOURCES

Bureau of Land and Water Resources

Southport Mall

P.O. Box 10631

Jackson, Mississippi 39209

WATER WELL DRILLERS LOG

Jackson
Harrison

Jackson
J 2010

March 8 1986
date well completed

McNeil Pump & Well
firm name

county well located

LANDOWNER: 15305 Knowltd
Michael Trochuset
Ocean Springs Ms.
(mailing address)

| description of formations encountered | from | to |
|---------------------------------------|------|-----|
| hard | 0 | 50 |
| blue clay | 50 | 100 |
| mud | 100 | 160 |
| mud sand | 160 | 280 |
| f. sand | 280 | 300 |
| f. sand - mud | 300 | 390 |
| g. sand | 390 | 400 |
| sand - mud | 400 | 475 |
| c. sand | 475 | 500 |

WELL LOCATION: Latimer
sec. 3 T. 6 N. R. 9 E
2 miles north of Latimer
(distance) (direction) (nearest town)

WELL PURPOSE:
(home, irrigation, municipal, industrial)

- WELL COMPLETION DATA:
- (1) diameter (inches) 5.00
 - (2) total depth (feet) 2"
 - (3) static water level (feet) 60 (below) above top of ground.
 - (4) casing sch. 40 PVC 490' (material) (depth)
 - (size) if telescope see back.
 - (5) screen 10' (length) (depth to top)
 - 2" (size) sch. 80 (material)
 - (6) pump 1 (HP) 9 (yield gpm)
 - electric (type power)
 - (7) electric log (yes or no)
 - (organization running log)
 - (8) how well bottom plugged sand seal

RECEIVED


MAR 26 1986

Department of Natural Resources
Bureau of Land & Water Resources

DRILLERS REMARKS:

If well telescopes please sketch and show depths.

GROUND LEVEL

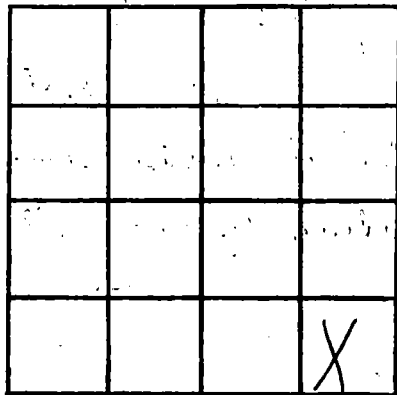

SECTION 3

Please indicate well location X.

ADDITIONAL INFORMATION

If more than one screen, show locations of each on sketch.