

MISSISSIPPI DEPARTMENT OF NATURAL RESOURCES

Bureau of Land and Water Resources

Southport Mall

P.O. Box 10631

Jackson, Mississippi 39209

WATER WELL DRILLERS LOG

JACKSON
 ✓ 2211

3-14-86
 date well completed

Coast Water Well Inc. Jackson
 firm name county well located

LANDOWNER: Richard Amey

10333 Antioch Rd

Vaneleave ms

(mailing address) 39564

WELL LOCATION:

sec 26 T. 6 N. R. 8 E
5 miles SE of VANCKAVE
 (distance) (direction) (nearest town)

WELL PURPOSE: HOME

(home, irrigation, municipal, industrial)

WELL COMPLETION DATA:

- (1) diameter (inches) 2"
- (2) total depth (feet) 500
- (3) static water level (feet) 50 below top of ground.
- (4) casing PVC 545'
 (material) (depth)
- 2" if telescope see back.
 (size)
- (5) screen 10' 545'
 (length) (depth to top)
- 2" PVC
 (size) (material)
- (6) pump _____
 (HP) (yield gpm)
- _____ (type power)
- (7) electric log no
 (yes or no)
- _____ (organization running log)

(8) how well is it logged? Backwash valve

DRILLERS REMARKS:

5' - 2" PVC tail pipe

description of formations encountered

from

to


Top Soil	0	2
Red Clay	2	16
Red Clay + streak of sand	16	40
Red Coarse sand	40	67
Blue Clay	67	170
Gray Coarse Sand	170	194
Blue Clay	194	300
Blue Clay + streak of sand	300	325
Gray Coarse Sand	325	380
Blue Clay	380	494
Gray Coarse Sand	494	557
Gray Coarse Sand and Gravel	557	560

RECEIVED
 MAY 12 1986

Department of Natural Resources
 Bureau of Land & Water Resources

If well telescopes please sketch and show depths.

GROUND LEVEL

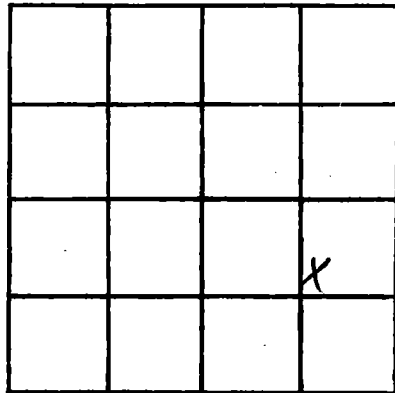

SECTION 26

Please indicate well location X.

ADDITIONAL INFORMATION

If more than one screen, show locations of each on sketch.