

MISSISSIPPI DEPARTMENT OF NATURAL RESOURCES

Bureau of Land and Water Resources

Southport Mall

P.O. Box 10631

Jackson, Mississippi 39209

WATER WELL DRILLERS LOG

JACKSON
J 2216

5-15-86<sup>19</sup> date well completed      Coastwaterwell firm name      Jackson county well located

LANDOWNER: <u>Mark Baker</u>	description of formations encountered	from	to
<u>10413 Fort Bayou Rd</u>	<u>Top Soil</u>	<u>0</u>	<u>2</u>
<u>Ocean Springs ms</u> (mailing address) <u>39564</u>	<u>Red Clay</u>	<u>2</u>	<u>16</u>
WELL LOCATION:	<u>Red Clay w/ streak of sand</u>	<u>16</u>	<u>40</u>
sec <u>26T 6E</u> R <u>8E</u> <u>5</u> miles <u>SW</u> of <u>VAN Cleave</u> (distance) (direction) (nearest town)	<u>Red Coarse Sand</u>	<u>40</u>	<u>67</u>
WELL PURPOSE: <u>home</u> (home, irrigation, municipal, industrial)	<u>Blue Clay</u>	<u>67</u>	<u>129</u>
WELL COMPLETION DATA:	<u>Gray Coarse Sand</u>	<u>129</u>	<u>165</u>
(1) diameter (inches) <u>2"</u>	<u>Blue Clay</u>	<u>165</u>	<u>170</u>
(2) total depth (feet) <u>170'</u>	<u>well 165</u>	<u>165</u>	<u>166</u>
(3) static water level (feet) <u>50</u> below above top of ground.			
(4) casing <u>PVC</u> <u>155'</u> (material) (depth) <u>2"</u> If telescope see back. (size)			
(5) screen <u>10'</u> <u>155'</u> (length) (depth to top)			
<u>2"</u> <u>PVC</u> (size) (material)			
(6) pump _____ (HP) (yield gpm)			
(type power)			
(7) electric log <u>no</u> (yes or no)			
(organization running log)			
(8) how well bottom plugged <u>backwash valve</u>			
DRILLERS REMARKS: <u>5' - 2" PVC tail pipe</u>			


RECEIVED

JUL 18 1986

Department of Natural Resources  
Bureau of Land & Water Resources

If well telescopes please sketch and show depths.

GROUND LEVEL

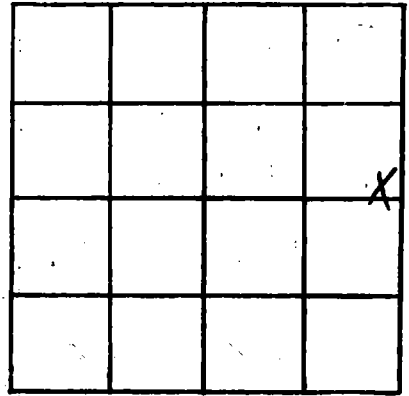

SECTION 26

Please indicate well location X.

ADDITIONAL INFORMATION

If more than one screen,  
show locations of each on sketch.