

MISSISSIPPI DEPARTMENT OF NATURAL RESOURCES

Bureau of Land and Water Resources

Southport Mall

P.O. Box 10631

Jackson, Mississippi 39209

WATER WELL DRILLERS LOG

Jackson
52217

878-1501
KHEW

5-20-86
date well completed

Coast Water Well
firm name

Jackson
county well located

LANDOWNER: Barry Adams
5709 Peacock St
Ocean Springs Ms.
(mailing address)

WELL LOCATION:
sec 15 T 6 R 9
IN miles (distance) — (direction) of LATIMER (nearest town)

WELL PURPOSE: home
(home, irrigation, municipal, industrial)

WELL COMPLETION DATA:

(1) diameter (inches) 2"

(2) total depth (feet) 210'

(3) static water level (feet) 20 below top of ground. above

(4) casing PVC (material), 195' (depth)
2" (size) if telescope see back.

(5) screen 10' (length), 195' (depth to top)
2" (size), PVC (material)

(6) pump 1 hp (HP), 14 (yield gpm)
elect (type power)

(7) electric log no (yes or no)
(organization running log)

(8) how well bottom plugged backwash valve

description of formations encountered	from	to
<u>Top Soil</u>	<u>0</u>	<u>2</u>
<u>Brown Clay</u>	<u>2</u>	<u>30</u>
<u>Blue Clay</u>	<u>30</u>	<u>164</u>
<u>Gray med Sand</u>	<u>164</u>	<u>208</u>
<u>Blue Clay</u>	<u>208</u>	<u>210</u>
		<u>Hole</u>

210
- 15

195
+ 10

205 well

RECEIVED


AUG 20 1986

Department of Natural Resources
Bureau of Land & Water Resources

DRILLERS REMARKS:
5" - 2" PVC tail pipe

If well telescopes please sketch and show depths.

GROUND LEVEL

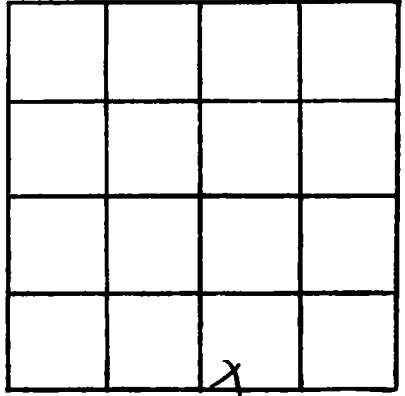

SECTION 15

Please indicate well location X.

ADDITIONAL INFORMATION

If more than one screen,
show locations of each on sketch.