

MISSISSIPPI DEPARTMENT OF NATURAL RESOURCES

Bureau of Land and Water Resources

Southport Mall

P.O. Box 10631

Jackson, Mississippi 39209

WATER WELL DRILLERS LOG

Jackson
J 22-20

7-21-86

Coast water well Jackson

date well completed

firm name

county well located

LANDOWNER: <u>TC Phylax</u> <u>9644 Comstock Ave</u> <u>Ocean Springs ms</u> (mailing address)	description of formations encountered	from	to
WELL LOCATION: sec. <u>35</u> T <u>6</u> N R <u>9</u> E <u>3</u> miles <u>NE</u> of <u>D'IBERVILLE</u> (distance) (direction) (nearest town)	Top Soil	0	3
WELL PURPOSE: <u>home</u> (home, irrigation, municipal, industrial)	Red Clay	3	15
WELL COMPLETION DATA: (1) diameter (inches) <u>2"</u>	Blue Clay	15	31
(2) total depth (feet) <u>425' hole</u>	White Coarse Sand + Gravel	31	40
(3) static water level (feet) <u>25</u> below top of ground	Blue Clay	40	168
(4) casing <u>PVC</u> (material), <u>400'</u> (depth), <u>400'</u> (depth) <u>2"</u> (size) if telescope see back <u>425'</u>	Blue Clay + Streak of Sand	168	220
(5) screen <u>20'</u> (length), <u>400'</u> (depth to top), <u>2"</u> (size), <u>PVC</u> (material)	Blue Clay	220	312
(6) pump <u>2</u> (HP), <u>8</u> (yield gpm), <u>Elect</u> (type power)	Blue Clay + Cyster. Shale	312	365
(7) electric log <u>no</u> (yes or no), (organization running log)	Gray Fine Sand	365	385
(8) how well bottom plugged <u>backwash valve</u>	Gray Coarse Sand	385	425
DRILLERS REMARKS: <u>5' 2" PVC tailpipe</u>			


RECEIVED

AUG 26 1986

Department of Natural Resources
Bureau of Land & Water Resources

If well telescopes please sketch and show depths.

GROUND LEVEL

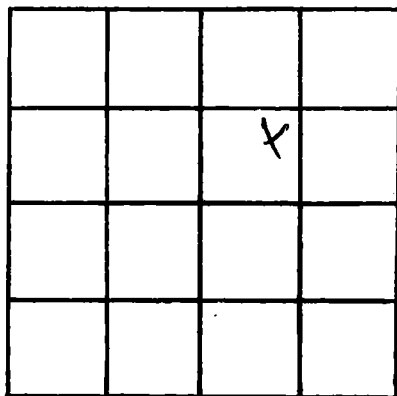

SECTION 35

Please indicate well location X.

ADDITIONAL INFORMATION

If more than one screen, show locations of each on sketch.