

MISSISSIPPI DEPARTMENT OF NATURAL RESOURCES

Bureau of Land and Water Resources

Southport Mall

P.O. Box 10631

Jackson, Mississippi 39209

WATER WELL DRILLERS LOG

JACKSON
J 2221

8-11-86
date well completed

Coastwater Well Jackson
firm name county well located

LANDOWNER: Tony Olsen
PO Box 5172
Vandevae MS
(mailing address)

WELL LOCATION:
sec 22 T 6 N R 8 E W
5 1/2 miles SW of VANDAEVE
(distance) (direction) (nearest town)

WELL PURPOSE: home
(home, irrigation, municipal, industrial)


WELL COMPLETION DATA:
(1) diameter (inches) 2"
(2) total depth (feet) 471' Holz
(3) static water level (feet) 63 below top of ground.
(4) casing PVC, 446' (material) (depth)
2" (size) If telescope see back.
(5) screen 20' (length), 446' (depth to top)
2" (size), PVC (material)
(6) pump (HP) (yield gpm)
(type power)
(7) electric log no (yes or no)
(organization running log)

(8) how well bottom plugged
backwash

DRILLERS REMARKS:
5' - 2" PVC tail pipe

Description of formations encountered	from	to
Top Soil	0	1
Red Clay	1	53
Blue Clay	53	190
Gray Fine Sand	190	210
Blue Clay	210	390
Gray Fine Sand	390	410
Gray med Sand	410	471

446
+ 26
well 476

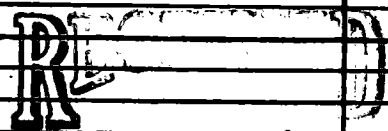

SEP 11 1986

Department of Natural Resources
Bureau of Land & Water Resources

