

MISSISSIPPI DEPARTMENT OF NATURAL RESOURCES

Bureau of Land and Water Resources

Southport Mall

P.O. Box 10631

Jackson, Mississippi 39209

WATER WELL DRILLERS LOG

JACKSON
J2923

8-12-86 19 Coast water well Jackson
date well completed firm name county well located

LANDOWNER: Pottymore Farms Rt 4 Box 9009 Vanceleve ms (mailing address)	Description of formations encountered	from to
	Top soil	0 1
	Red Clay	1 15
	Red coarse sand	15 61
	Red coarse sand + gravel	61 64
<p>WELL LOCATION: sec 23 T 6 N R 8 E W 5 miles SW of VANCELEVE (distance) (direction) (nearest town)</p>		
<p>WELL PURPOSE: home (home, irrigation, municipal, industrial)</p>		
<p>WELL COMPLETION DATA:</p>		
(1) diameter (inches) 2"		
(2) total depth (feet) 64' use	49	
(3) static water level (feet) 13' below top of ground.	10	
(4) casing PUC, 49' (material), (depth)	59	
2" (size) If telescope see back.		
(5) screen 10', 49' (length), (depth to top)		
2" (size), PUC (material)		
(6) pump (HP) (yield gpm)		
(type power)		
(7) electric log no (yes or no)		
(organization running log)		
(8) how well bottom plugged backwash		
<p>DRILLERS REMARKS: 5'-2" PUC tail pipe</p>		


RECEIVED

SEP 11 1986

Department of Natural Resources
Bureau of Land & Water Resources

If well telescopes please sketch and show depths.

GROUND LEVEL

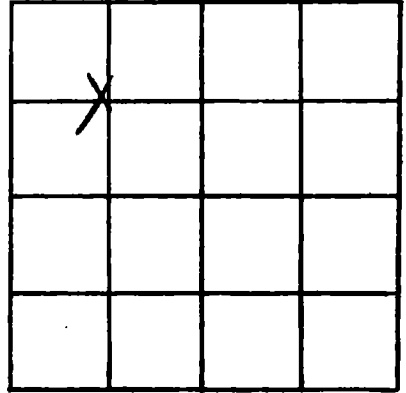

SECTION 23

Please indicate well location X.

ADDITIONAL INFORMATION

Lined area for additional information.

If more than one screen, show locations of each on sketch.