

MISSISSIPPI DEPARTMENT OF NATURAL RESOURCES

Bureau of Land and Water Resources

Southport Mall

P.O. Box 10631

Jackson, Mississippi 39209

WATER WELL DRILLERS LOG

JACKSON
J 2224

8-12-86 ¹⁹ Coast water well Jackson
date well completed firm name county well located

LANDOWNER: David Forshope
16000 Krohn Rd.
Ocean Springs Ms.
(mailing address)

WELL LOCATION:
sec. 15 T. 6 N. R. 9 E.
8 1/2 miles NW of OCEAN Springs
(distance) (direction) (nearest town)

WELL PURPOSE: home
(home, irrigation, municipal, industrial)

WELL COMPLETION DATA:
(1) diameter (inches) 2"
(2) total depth (feet) 270'
(3) static water level (feet) 20' below top of ground.
(4) casing PUC, 255' (material), (depth)
2" (size) if telescope see back.
(5) screen 10', 255' (length), (depth to top)
2" PUC (size), (material)
(6) pump 1hp 6 (HP), (yield gpm)
elect. (type power)
(7) electric log NO (yes or no)
(organization running log)

(8) how well bottom plugged backwash valve

DRILLERS REMARKS:
5ft 2" PUC tailpipe

description of formations encountered	from	to
Top Soil	0	1
Red Sand	1	5
White Coarse Sand	5	20
Blue Clay	20	25
Gray med Sand	25	26
Blue Clay	26	27
Hole	27	27
255 + 10 well 265		


RECEIVED

SEP 11 1986

Department of Natural Resources
Bureau of Land & Water Resources

If well telescopes please sketch and show depths.

GROUND LEVEL

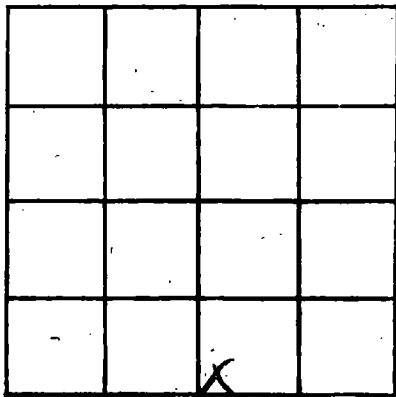

SECTION 15

Please indicate well location X.

ADDITIONAL INFORMATION

If more than one screen, show locations of each on sketch.