

MISSISSIPPI DEPARTMENT OF NATURAL RESOURCES

Bureau of Land and Water Resources

Southport Mall

P.O. Box 10631

Jackson, Mississippi 39209

WATER WELL DRILLERS LOG

JACKSON  
F 2226

8-15-86  
date well completed

19 Coast water well  
firm name

JACKSON  
county well located

LANDOWNER: Doug Vermillion  
10432 Antioch Rd.  
Vandœuvre MS 39564  
(mailing address)

WELL LOCATION:  
sec. 26 T. 6 N. R. 8 E. S. 3 W. 4  
4 1/2 miles SW of Vandœuvre  
(distance) (direction) (nearest town)

WELL PURPOSE: home  
(home, irrigation, municipal, industrial)

WELL COMPLETION DATA:

- (1) diameter (Inches) 2"
- (2) total depth (feet) 369' hole
- (3) static water level (feet) 68' below top of ground.
- (4) casing PVC, 344' (depth), 2" (size) if telescope see back, 344' hole
- (5) screen 20' (length), 344' (depth to top), 2" (size), PVC (material)
- (6) pump 1hp (HP), 7 (yield gpm), elect (type power)
- (7) electric log NO (yes or no)  
(organization running log)
- (8) how well bottom plugged Duckwash valve

description of formations encountered	from	to
Top Soil	0	2
Red Clay	2	16
Red Clay + streak of sand	16	40
Red coarse sand	40	67
Blue Clay	67	130
Blue Clay + streak of sand	130	160
Gray coarse sand	160	175
Blue Clay	175	300
Blue Clay + streak of sand	300	325
Gray coarse sand	325	364
Blue Clay	364	369

RECEIVED


SEP 11 1986

DRILLERS REMARKS:  
5' - 2" PVC tail pipe.

Department of Natural Resources  
Bureau of Land & Water Resources

If well telescopes please sketch and show depths.

GROUND LEVEL

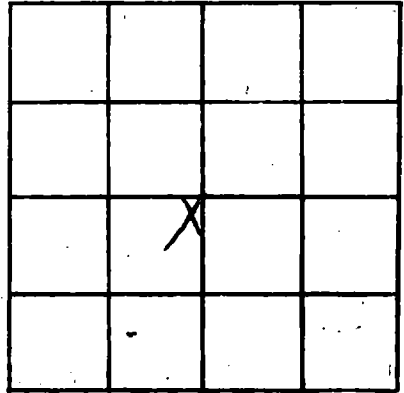

SECTION 26

Please indicate well location X.

ADDITIONAL INFORMATION

If more than one screen, show locations of each on sketch.