

**MISSISSIPPI DEPARTMENT OF NATURAL RESOURCES**  
**Bureau of Land and Water Resources**  
 Southport Mall  
 P.O. Box 10631  
 Jackson, Mississippi 39209  
**WATER WELL DRILLERS LOG**

JACKSON  
52227

8-19-86 19 1986 Good water well Jackson  
 date well completed firm name county well located

LANDOWNER: Sheila Jemerson  
12317 Keg's Place  
Ocean Springs Ms.  
 (mailing address)

WELL LOCATION:  
 sec. 35 T. 6 N. R. 9 E.  
6 miles NW of Ocean Springs  
 (distance) (direction) (nearest town)

WELL PURPOSE: home  
 (home, irrigation, municipal, industrial)

WELL COMPLETION DATA:

(1) diameter (inches) 2"

(2) total depth (feet) 430' hole

(3) static water level (feet) 82 below above top of ground.

(4) casing PVC, 400',  
 (material) (depth)  
2" If telescope see back.  
 (size)

(5) screen 20', 400'  
 (length) (depth to top)  
2", PVC  
 (size) (material)

(6) pump 2, 8'  
 (HP) (yield gpm)  
Eled.  
 (type power)

(7) electric log no  
 (yes or no)  
 (organization running log)

(8) hole well bottom plugged backwash valve


| description of formations encountered | from       | to         |
|---------------------------------------|------------|------------|
| <u>Top Soil</u>                       | <u>0</u>   | <u>2</u>   |
| <u>Brown Clay</u>                     | <u>2</u>   | <u>22</u>  |
| <u>White Coarse Sand + Gravel</u>     | <u>22</u>  | <u>31</u>  |
| <u>Blue Clay</u>                      | <u>31</u>  | <u>180</u> |
| <u>fine sand</u>                      | <u>180</u> | <u>200</u> |
| <u>blue clay</u>                      | <u>200</u> | <u>295</u> |
| <u>Gray coarse sand</u>               | <u>295</u> | <u>310</u> |
| <u>blue clay</u>                      | <u>310</u> | <u>315</u> |
| <u>Blue Clay + clam</u>               | <u>315</u> | <u>360</u> |
| <u>Gray Fine Sand</u>                 | <u>360</u> | <u>385</u> |
| <u>Gray med Sand</u>                  | <u>385</u> | <u>420</u> |
| <u>Blue Clay</u>                      | <u>420</u> | <u>430</u> |

DRILLERS REMARKS:  
10ft 2" PVC tail pipe

400  
 20  
 with 2" **RECEIVED**  
 SEP 11 1986

If well telescopes please sketch and show depths.

GROUND LEVEL

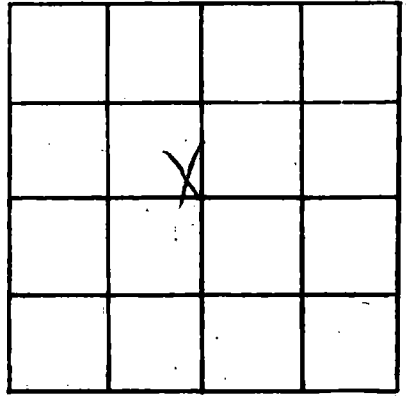

SECTION 35

Please indicate well location X.

ADDITIONAL INFORMATION

If more than one screen, show locations of each on sketch.