

MISSISSIPPI DEPARTMENT OF NATURAL RESOURCES

Bureau of Land and Water Resources

Southport Mall

P.O. Box 10631

Jackson, Mississippi 39209

WATER WELL DRILLERS LOG

Jackson
52229

10-9 1986 De Price Drilling Co. Jackson
date well completed firm name county well located

LANDOWNER: Robert Bassett
Seaman Rd.
Vanclave, Ms
(mailing address)

description of formations encountered	from	to
<u>top soil</u>	<u>0</u>	<u>10</u>
<u>Sand & Clay</u>	<u>10</u>	<u>30</u>
<u>good Sand</u>	<u>30</u>	<u>60</u>
<u>sand & Clay</u>	<u>60</u>	<u>120</u>
<u>Clay</u>	<u>120</u>	<u>260</u>
<u>good Sand</u>	<u>260</u>	<u>275</u>

WELL LOCATION:
sec 27 T. 6 N R. 8 E
6 miles SW of Vanclave
(distance) (direction) (nearest town)

WELL PURPOSE:
(home irrigation, municipal, industrial)

WELL COMPLETION DATA:

(1) diameter (inches) 2'

(2) total depth (feet) 275'

(3) static water level (feet) 50 below above top of ground.

(4) casing plastic, 270'
(material) (depth)

0 if telescope see back.
(size)

(5) screen 5', 275'
(length) (depth to top)

006, plastic
(size) (material)

(6) pump 1 8
(HP) (yield gpm)

electric
(type power)

(7) electric log (yes or no)

(organization running log)

(8) how well bottom plugged BW

RECEIVED


OCT 15 1986

Department of Natural Resources
Bureau of Land & Water Resources

DRILLERS REMARKS:

If well telescopes please sketch and show depths.

GROUND LEVEL

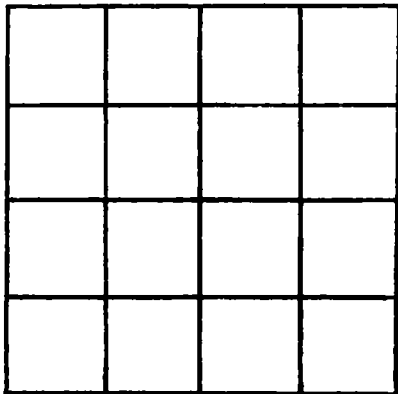

SECTION _____

Please indicate well location X.

ADDITIONAL INFORMATION

If more than one screen,
show locations of each on sketch.