

MISSISSIPPI DEPARTMENT OF NATURAL RESOURCES
Bureau of Land and Water Resources

P.O. Box 10631
Jackson, Mississippi 39209
WATER WELL DRILLERS LOG

COUNTY WELL LOCATED Jackson	
WELL NUMBER J 2235	CODED
DATE WELL COMPLETED 12-29-86	

PERMIT NUMBER
NAME OF DRILLING FIRM Coast Waterwell

NAME & MAILING ADDRESS OF LANDOWNER Carl Gardner		
Shetland PR		
VAN CLEAVE MS		
WELL LOCATION: SEC	TOWNSHIP	RANGE
26	6 S	8 E
DISTANCE 5 Miles	DIRECTION SW	NEAREST TOWN of VAN CLEAVE
OTHER LANDMARK		
WELL PURPOSE: Home, Irrigation, Municipal, Industrial, Fish Pond, etc. Home		

PUMP DATA		
PUMP TYPE (Circle One): Submersible, Turbine, Jet, Flowing Well, Other (Describe) _____		
POWER TYPE (Circle One): Electric, Tractor, Diesel, Gasoline, Butane, Other (Describe) _____		
Pump Capacity (GPM)	No. of Stages	Setting Depth FT.
PUMP TEST		
Well yielded _____ GPM with a drawdown of _____ ft. after _____ hours of pumping		

WELL DATA		
Well Depth 70'65	Casing Diameter (In.) 2"	Casing Length (Ft.) 55'
Type of Casing PUC	Hole Depth 70'	Depth to Static Water Level 11'
TYPE OF COMPLETION: (Circle One or More): Gravel Packed, Underreamed, Telescoped, Natural Development , Open Hole, Other		
Top of Lap Pipe or Reduction in Casing FEET		
IF TELESCOPED OR MORE THAN ONE SCREEN: USE BACK PAGE		

LOG DATA	
TYPE OF LOG RUN (Circle One): Electric, Gamma Ray, Density, Sonic, Neutron, Other (Describe) _____	
Name of Organization Running Log No Log Run.	

SCREEN DATA		
Diameter - Inches 2"	Length - Feet 10'	Slot Size - Inches .008
Screen Type PUC	Depth to Bottom - Feet 65'	


GEOLOGIC DATA (Office Use Only)			
Surface Elev.	Geologic Unit	Unit Thickness	Depth to Top
Subs. SWL	Date	Analysis	Aquifer Test
Driller's Remarks			

DESCRIPTION OF FORMATIONS ENCOUNTERED	FROM	TO
Top Soil	0	1
Brown Clay	1	25
White Coarse Sand	25	65
Blue Clay	65	70

FORMATIONS (Continued)	FROM	TO
RECEIVED		
MAY 21 1987		
Department of Natural Resources		
Bureau of Land & Water Resources		
IF MORE SPACE IS NEEDED, USE BACK		

If well telescopes please sketch and show depths.

GROUND LEVEL

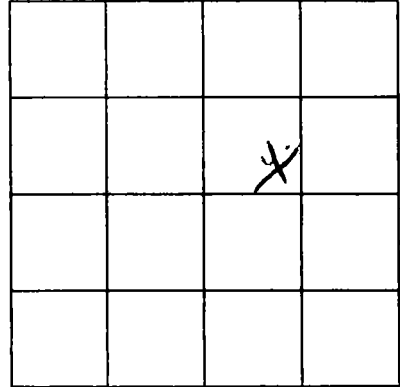

SECTION 26

Please indicate well location X.

ADDITIONAL INFORMATION

Lined area for additional information.

If more than one screen, show location of each on sketch.