

**MISSISSIPPI DEPARTMENT OF NATURAL RESOURCES**  
Bureau of Land and Water Resources

P.O. Box 10631

Jackson, Mississippi 39209  
**WATER WELL DRILLERS LOG**

COUNTY WELL LOCATOR <u>Jackson</u>	
WELL NUMBER <u>22236</u>	CODED
DATE WELL COMPLETED <u>1-5-87</u>	

PERMIT NUMBER
NAME OF DRILLING FIRM <u>Coast Water Well</u>

NAME & MAILING ADDRESS OF LANDOWNER <u>Michelle Skermetta</u>		
<u>Haveno Rd</u>		
<u>Vandclave Mo</u>		
WELL LOCATION: SEC	TOWNSHIP	RANGE
<u>12</u>	<u>6</u>	<u>8</u>
	<u>N</u>	<u>E</u>
DISTANCE <u>3 1/2</u> Miles	DIRECTION <u>W</u>	NEAREST TOWN <u>Vandclave</u>
OTHER LANDMARK		
WELL PURPOSE: Home, Irrigation, Municipal, Industrial, Fish Pond, etc. <u>home</u>		

<b>PUMP DATA</b>		
PUMP TYPE (Circle One): Submersible, Turbine, <u>Jet</u> Flowing Well, Other (Describe) _____		
POWER TYPE (Circle One): <u>Electric</u> , Tractor, Diesel, Gasoline, Butane, Other (Describe) _____		
Pump Capacity (GPM) <u>10</u>	No. of Stages <u>3</u>	Setting Depth <u>—</u> FT.
PUMP TEST		
Well yielded <u>—</u> GPM with a drawdown of <u>—</u> ft. after <u>—</u> hours of pumping		

<b>WELL DATA</b>		
Well Depth <u>480</u> <u>475</u>	Casing Diameter (In.) <u>2</u>	Casing Length (Ft.) <u>455</u>
Type of Casing <u>PVC</u>	Hole Depth <u>480'</u>	Depth to Static Water Level <u>65'</u>
TYPE OF COMPLETION: (Circle One or More): <u>Natural Development</u> , Gravel Packed, Underreamed, Telescoped, Open Hole, Other		
Top of Lap Pipe or Reduction in Casing		
FEET		
IF TELESCOPED OR MORE THAN ONE SCREEN: USE BACK PAGE		


<b>LOG DATA</b>	
TYPE OF LOG RUN (Circle One): Electric, Gamma Ray, Density, Sonic, Neutron, Other (Describe) _____	
<u>No Log Run</u>	
Name of Organization Running Log	

<b>SCREEN DATA</b>		
Diameter - Inches <u>2"</u>	Length - Feet <u>20'</u>	Slot Size - Inches <u>.008</u>
Screen Type <u>PVC</u>	Depth to Bottom - Feet <u>475'</u>	

<b>GEOLOGIC DATA (Office Use Only)</b>			
Surface Elev.	Geologic Unit	Unit Thickness	Depth to Top
Subs. SWL	Date	Analysis	Aquifer Test


Driller's Remarks

DESCRIPTION OF FORMATIONS ENCOUNTERED	FROM	TO
<u>Top Soil</u>	<u>0</u>	<u>1</u>
<u>Red Clay</u>	<u>1</u>	<u>10</u>
<u>White Coarse Sand w/ Pea Gravel</u>	<u>10</u>	<u>187</u>
<u>Blue Clay</u>	<u>187</u>	<u>326</u>
<u>Fine Gray Sand</u>	<u>326</u>	<u>335</u>
<u>Blue Clay</u>	<u>335</u>	<u>430</u>
<u>Gray Coarse Sand</u>	<u>430</u>	<u>475</u>
<u>Blue Clay</u>	<u>475</u>	<u>480</u>
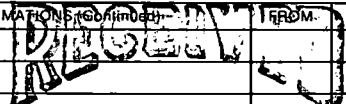
<b>FORMATIONS (continued)</b>		FROM	TO
			
MAY 21 1987			
Department of Natural Resources Bureau of Land & Water Resources			
IF MORE SPACE IS NEEDED, USE BACK			

If well telescopes please sketch and show depths.

GROUND LEVEL

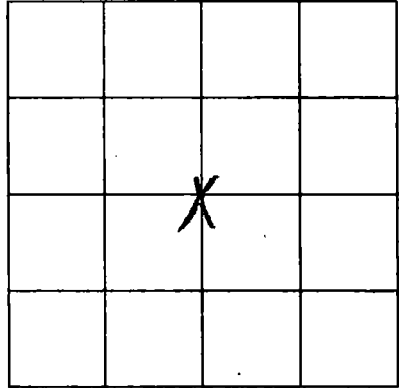

SECTION 12

Please indicate well location X.

ADDITIONAL INFORMATION

Lined area for additional information.

If more than one screen, show location of each on sketch.