

MISSISSIPPI DEPARTMENT OF NATURAL RESOURCES

Bureau of Land and Water Resources

Southport Mall

P.O. Box 10631

Jackson, Mississippi 39209

WATER WELL DRILLERS LOG

COASTAL DRILLING & SERVICE CO.

~~Jackson~~
JACKSON
 J 22 38
 Oct 15, 1986

date well completed

RT. 11, BOX 81

Jackson
 county well located

BILOXI, MS 39532

LANDOWNER:

Raymond
Goodwin

description of formations encountered

from to

top soil	1	10
red clay	10	70
blue clay	70	90
fine water sand	90	100
good water sand	100	110

Ocean Springs MS
 (mailing address)

WELL LOCATION:

sec. 7 T. 6 N. R. 8 W.
 (distance) miles (direction) (nearest town)

WELL PURPOSE: home
 (home, irrigation, municipal, industrial)

WELL COMPLETION DATA:

- (1) diameter (inches) 2"
- (2) total depth (feet) 110
- (3) static water level (feet) 10 below above top of ground.
- (4) casing pvc, 100,
 (material) (depth)
 (size) If telescope see back.
- (5) screen 10', 100
 (length) (depth to top)
2", pvc
 (size) (material)
- (6) pump 1 (HP) 12 (yield gpm)
Elec.
 (type power)
- (7) electric log no
 (yes or no)

RECEIVED

JUL 1 1987


(organization running log)
 (8) how well bottom plugged 2' back
wash valve

DRILLERS REMARKS:

Department of Natural Resources
 Bureau of Land & Water Resources

If well telescopes please sketch and show depths.

GROUND LEVEL

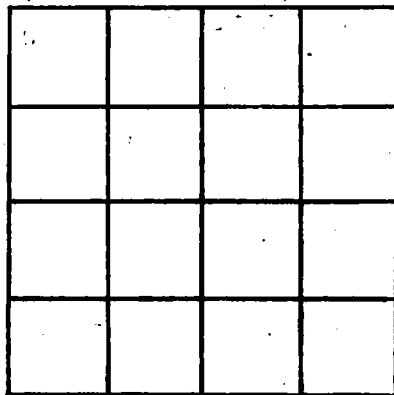

SECTION _____

Please indicate well location X.

ADDITIONAL INFORMATION

If more than one screen,
show locations of each on sketch.