

MISSISSIPPI DEPARTMENT OF NATURAL RESOURCES

Bureau of Land and Water Resources

Southport Mall

P.O. Box 10631

Jackson, Mississippi 39209

WATER WELL DRILLERS LOG

Jackson  
J 22 39

11-17-1986 Pierce Drilling Co. Jackson  
date well completed firm name county well located


LANDOWNER: <u>Rick John</u>	description of formations encountered	from	to
<u>Vanclave, ms</u> (mailing address)	<u>top soil</u>	<u>0</u>	<u>10</u>
	<u>clay</u>	<u>10</u>	<u>20</u>
	<u>good sand</u>	<u>20</u>	<u>68</u>
<b>WELL LOCATION:</b>			
sec. <u>15</u> T <u>6</u> N R. <u>8</u> E <u>4</u> miles <u>West</u> of <u>Vanclave</u> (distance) (direction) (nearest town)			
<b>WELL PURPOSE:</b>			
<u>(home)</u> Irrigation, municipal, industrial			
<b>WELL COMPLETION DATA:</b>			
(1) diameter (inches) <u>4"</u>			
(2) total depth (feet) <u>68'</u>			
(3) static water level (feet) <u>30'</u> <u>below</u> above top of ground.			
(4) casing <u>plastic</u> , <u>53'</u> (material) (depth)			
<u>0</u> If telescope see back. (size)			
(5) screen <u>15'</u> , <u>68'</u> (length) (depth to top)			
<u>006</u> , <u>plastic</u> (size) (material)			
(6) pump <u>1</u> <u>30</u> (HP) (yield gpm)			
<u>electric</u> (type power)			
(7) electric log _____ (yes or no)			
(organization running log)			
(8) how well bottom plugged <u>BW</u>			
<b>DRILLERS REMARKS:</b>			

RECEIVED  
SEP 15 1987

Department of Natural Resources  
Bureau of Land & Water Resources

If well telescopes please sketch and show depths.

GROUND LEVEL

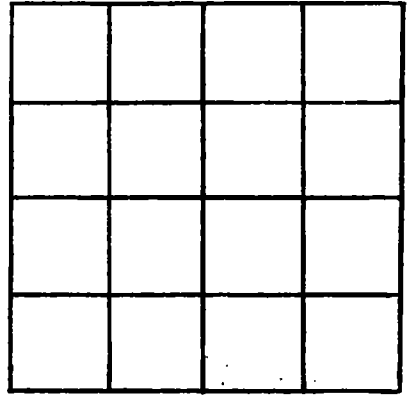

SECTION \_\_\_\_\_

Please indicate well location X.

ADDITIONAL INFORMATION

If more than one screen, show locations of each on sketch.