

**MISSISSIPPI DEPARTMENT OF NATURAL RESOURCES**  
Bureau of Land and Water Resources

P.O. Box 10631  
Jackson, Mississippi 39209  
**WATER WELL DRILLERS LOG**

COUNTY WELL LOCATED <b>Jackson</b>
WELL NUMBER (CODED) <b>7244</b>
DATE WELL COMPLETED <b>5-8-87</b>

PERMIT NUMBER
NAME OF DRILLING FIRM <b>Coast Water Well Ser. Inc</b>

NAME & MAILING ADDRESS OF LANDOWNER <b>Dwayne Radner</b>		
<b>Jim Ramsey RD</b>		
<b>VAN CLEARS MS</b>		
WELL LOCATION: SEC	TOWNSHIP	RANGE
<b>18</b>	<b>6 S</b>	<b>8 W</b>
DISTANCE <b>7</b> Miles	DIRECTION <b>N</b> of	NEAREST TOWN <b>Ocean Springs</b>
OTHER LANDMARK		
WELL PURPOSE: Home, Irrigation, Municipal, Industrial, Fish Pond, etc. <b>Home</b>		

<b>PUMP DATA</b>		
PUMP TYPE (Circle One): Submersible, Turbine, <b>Jet</b> Flowing Well, Other (Describe) _____		
POWER TYPE (Circle One): <b>Electric</b> , Tractor, Diesel, Gasoline, Butane, Other (Describe) _____		
Pump Capacity (GPM) <b>8</b>	No. of Stages <b>2</b>	Setting Depth <b>_____</b> FT.
PUMP TEST		
Well yielded _____ GPM with a drawdown of <b>X</b> ft. after _____ hours of pumping		

<b>WELL DATA</b>		
Well Depth <b>468</b>	Casing Diameter (In.) <b>2"</b>	Casing Length (Ft.) <b>450'</b>
Type of Casing <b>PVC</b>	Hole Depth <b>465'</b>	Depth to Static Water Level <b>60'</b>
TYPE OF COMPLETION: (Circle One or More): Gravel Packed, Underreamed, Telescoped, <b>Natural Development</b> , Open Hole, Other (Describe) _____		
Top of Lap Pipe or Reduction in Casing		
FEET	IF TELESCOPED OR MORE THAN ONE SCREEN: USE BACK PAGE	

<b>LOG DATA</b>	
TYPE OF LOG RUN (Circle One): Electric, Gamma Ray, Density, Sonic, <b>No Log Run</b> , Neutron, Other (Describe) _____	
Name of Organization Running Log	

<b>SCREEN DATA</b>		
Diameter - Inches <b>2</b>	Length - Feet <b>10'</b>	Slot Size - Inches <b>.008</b>
Screen Type <b>PVC</b>	Depth to Bottom - Feet <b>460'</b>	

<b>GEOLOGIC DATA (Office Use Only)</b>			
Surface Elev.	Geologic Unit	Unit Thickness	Depth to Top
Subs. SWL	Date	Analysis	Aquifer Test

Driller's Remarks

DESCRIPTION OF FORMATIONS ENCOUNTERED	FROM	TO	FORMATION (Continued)	FROM	TO
<b>Top Soil</b>	<b>0</b>	<b>2</b>	<b>RECEIVED</b> <b>SEP 21 1987</b> Department of Natural Resources Bureau of Land & Water Resources		
<b>Broken Clay</b>	<b>2</b>	<b>16</b>			
<b>Blue Clay</b>	<b>16</b>	<b>75</b>			
<b>Gray Coarse Sand</b>	<b>75</b>	<b>145</b>			
<b>Blue Clay</b>	<b>145</b>	<b>149</b>			
<b>Gray Coarse sand</b>	<b>149</b>	<b>210</b>			
<b>Blue Clay</b>	<b>210</b>	<b>370</b>			
<b>Gray fine sand w/ streaks of Blue Clay</b>	<b>370</b>	<b>415</b>			
<b>Gray Med Sand</b>	<b>415</b>	<b>460</b>			
<b>Blue Clay</b>	<b>460</b>	<b>465</b>			

IF MORE SPACE IS NEEDED, USE BACK


If well telescopes please  
sketch and show depths.

GROUND LEVEL

DEVELOPER

1981 12 12

See if telescope in the report  
on page 101 of the report to records

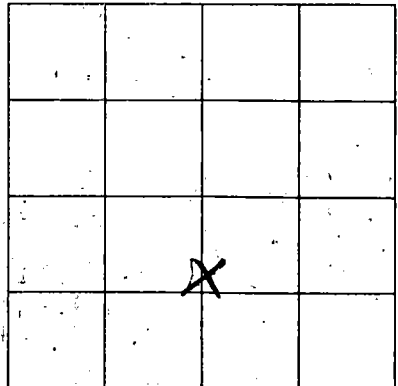

SECTION 18

Please indicate well location X.

ADDITIONAL INFORMATION