

MISSISSIPPI DEPARTMENT OF NATURAL RESOURCES
Bureau of Land and Water Resources

P.O. Box 10631
Jackson, Mississippi 39209
WATER WELL DRILLERS LOG

COUNTY WELL LOCATED <i>Jackson</i>	
WELL NUMBER <i>52241</i>	CODED
DATE WELL COMPLETED <i>6-3-87</i>	

PERMIT NUMBER
NAME OF DRILLING FIRM <i>Coast Water Well Sew.</i>

NAME & MAILING ADDRESS OF LANDOWNER <i>Kell Martin</i>			
<i>10901 Antwac Rd</i>			
<i>Ocean Springs MS</i>			
WELL LOCATION:	SEC	TOWNSHIP	RANGE
	<i>27</i>	<i>6 S</i>	<i>8 W</i>
DISTANCE	DIRECTION	NEAREST TOWN	
<i>5</i> Miles	<i>SW</i>	<i>Vanclave</i>	
OTHER LANDMARK			
WELL PURPOSE: Home, Irrigation, Municipal, Industrial, Fish Pond, etc. <i>Home</i>			

PUMP DATA		
PUMP TYPE (Circle One): Submersible, Turbine, Jet Flowing Well, Other (Describe) _____		
POWER TYPE (Circle One): Electric Tractor, Diesel, Gasoline, Butane, Other (Describe) _____		
Pump Capacity (GPM) <i>12</i>	No. of Stages <i>2</i>	Setting Depth <i>—</i> FT.
PUMP TEST		
Well yielded _____ GPM with a drawdown of _____ ft. after _____ hours of pumping		

WELL DATA		
Well Depth <i>736' 31"</i>	Casing Diameter (In.) <i>2"</i>	Casing Length (Ft.) <i>711'</i>
Type of Casing <i>PVC</i>	Hole Depth <i>736'</i>	Depth to Static Water Level <i>20'</i>
TYPE OF COMPLETION: (Circle One or More): Gravel Packed , Underreamed, Telescoped, Natural Development , Open Hole, Other (Describe) _____		
Top of Lap Pipe or Reduction in Casing		
FEET	IF TELESCOPED OR MORE THAN ONE SCREEN: USE BACK PAGE	

LOG DATA	
TYPE OF LOG RUN (Circle One): Electric, Gamma Ray, Density, Sonic, No Log Run , Other (Describe) _____	
Name of Organization Running Log	

SCREEN DATA		
Diameter - Inches <i>2"</i>	Length - Feet <i>20'</i>	Slot Size - Inches <i>.008</i>
Screen Type <i>PVC</i>	Depth to Bottom - Feet <i>734'</i>	

GEOLOGIC DATA (Office Use Only)			
Surface Elev.	Geologic Unit	Unit Thickness	Depth to Top
Subs. SWL	Date	Analysis	Aquifer Test
Driller's Remarks			


RECEIVED
SEP 21 1987

DESCRIPTION OF FORMATIONS ENCOUNTERED	FROM	TO	FORMATION (Continued)	FORMATION TO
<i>Top Soil</i>	<i>0</i>	<i>1</i>		
<i>Shaly Clay</i>	<i>1</i>	<i>20</i>		
<i>White Coarse Sand</i>	<i>20</i>	<i>80</i>		
<i>Blue Clay</i>	<i>80</i>	<i>113</i>		
<i>Gray Med. Sand</i>	<i>113</i>	<i>134</i>		
<i>Blue Clay</i>	<i>134</i>	<i>175</i>		
<i>Gray Med. Sand</i>	<i>175</i>	<i>211</i>		
<i>Blue Clay</i>	<i>211</i>	<i>686</i>		
<i>Gray med Sand</i>	<i>686</i>	<i>731</i>		
<i>Blue Clay</i>	<i>731</i>	<i>736</i>		

IF MORE SPACE IS NEEDED, USE BACK

If well telescopes please sketch and show depths.

GROUND LEVEL

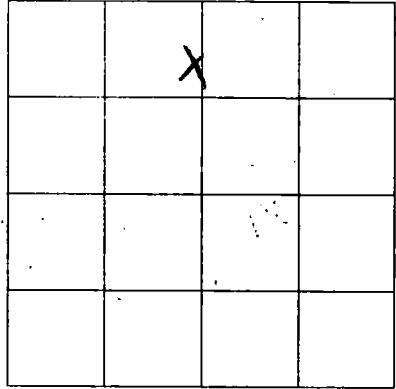

SECTION 27

Please indicate well location X.

ADDITIONAL INFORMATION

Lined area for additional information.

If more than one screen, show location of each on sketch.