

w. + pur

add-loc-pump
MISSISSIPPI DEPARTMENT OF NATURAL RESOURCES
 Bureau of Land and Water Resources

COUNTY WELL LOCATED
Jackson

WELL NUMBER CODED
J2252

DATE WELL COMPLETED
11-2-87

PERMIT NUMBER

NAME OF DRILLING FIRM
Coastwater Well Service

P.O. Box 10631
 Jackson, Mississippi 39209
WATER WELL DRILLERS LOG

NAME & MAILING ADDRESS OF LANDOWNER
Charles King
PO Box 228
Ocean Springs MS

WELL LOCATION: SEC TOWNSHIP RANGE
15 6 S 8 E W

DISTANCE DIRECTION NEAREST TOWN
5 Miles **W** of **Vandeventer**

OTHER LANDMARK

WELL PURPOSE: Home, Irrigation, Municipal, Industrial, Fish Pond, etc.
home

PUMP DATA

PUMP TYPE (Circle One):
 Submersible, Turbine, **(Jet)** Flowing Well,
 Other (Describe) _____

POWER TYPE (Circle One):
(Electric), Tractor, Diesel, Gasoline, Butane,
 Other (Describe) _____

Pump Capacity (GPM) 11	No. of Stages 2	Setting Depth - FT.
----------------------------------	---------------------------	-------------------------------

PUMP TEST
 Well yielded _____ GPM with
 a drawdown of _____ ft.
 after _____ hours of pumping

WELL DATA

Well Depth 53'	Casing Diameter (In.) 2"	Casing Length (Ft.) 45'
Type of Casing PVC	Hole Depth 53	Depth to Static Water Level 30'

TYPE OF COMPLETION: (Circle One or More):
 Gravel Packed, Underreamed, Telescoped,
(Natural Development), Open Hole, Other

Top of Lap Pipe or Reduction in Casing
 FEET IF TELESCOPED OR MORE THAN ONE SCREEN: USE BACK PAGE

LOG DATA

TYPE OF LOG RUN (Circle One):
 Electric, Gamma Ray, Density, Sonic, **(No Log Run)**,
 Other (Describe) _____

Name of Organization Running Log

SCREEN DATA

Diameter - Inches 2"	Length - Feet 5	Slot Size - Inches .008
Screen Type PVC	Depth to Bottom - Feet 50'	

GEOLOGIC DATA (Office Use Only)

Surface Elev.	Geologic Unit	Unit Thickness	Depth to Top
Subs. SWL	Date	Analysis	Aquifer Test

Driller's Remarks

DESCRIPTION OF FORMATIONS ENCOUNTERED	FROM	TO
Top Soil	0	2
Red Clay	2	42
white loess	42	50
sand	-	-
Red Clay	50	53

RECEIVED

MAY 24 1988


Department of Natural Resources
 Bureau of Land & Water Resources

IF MORE SPACE IS NEEDED, USE BACK

125L

If well telescopes please sketch and show depths.

GROUND LEVEL

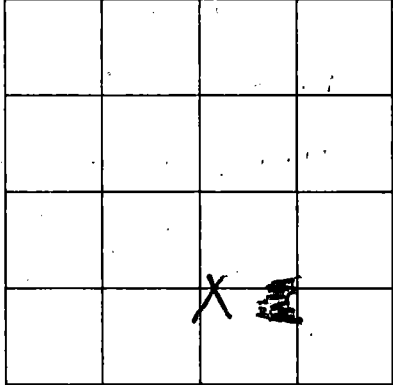

SECTION 15

Please indicate well location X.

ADDITIONAL INFORMATION

Lined area for additional information.

If more than one screen, show location of each on sketch.