

~~000~~ **loc-pump**
MISSISSIPPI DEPARTMENT OF NATURAL RESOURCES
 Bureau of Land and Water Resources

P.O. Box 10631
 Jackson, Mississippi 39209
WATER WELL DRILLERS LOG

COUNTY WELL LOCATED Jackson	
WELL NUMBER J2254	CODED
DATE WELL COMPLETED 10.23.87	

PERMIT NUMBER
NAME OF DRILLING FIRM Coastwater Well Service Inc.

NAME & MAILING ADDRESS OF LANDOWNER Emily Russell			
PO Box 5312			
Vancleave MS			
WELL LOCATION:	SEC	TOWNSHIP	RANGE
	14	6	8
		N	E
		S	W
DISTANCE	DIRECTION	NEAREST TOWN	
4	W	Vancleave	
OTHER LANDMARK			
WELL PURPOSE: Home, Irrigation, Municipal, Industrial, Fish Pond, etc. home			

PUMP DATA		
PUMP TYPE (Circle One): Submersible, Turbine, <input checked="" type="radio"/> Jet, Flowing Well, Other (Describe) _____		
POWER TYPE (Circle One): <input checked="" type="radio"/> Electric, Tractor, Diesel, Gasoline, Butane, Other (Describe) _____		
Pump Capacity (GPM) 7	No. of Stages 1	Setting Depth — FT.
PUMP TEST		
Well yielded _____ GPM with a drawdown of _____ ft. after _____ hours of pumping		

WELL DATA		
Well Depth 64	Casing Diameter (In.) 2"	Casing Length (Ft.) 54
Type of Casing PVC	Hole Depth 64	Depth to Static Water Level 20'
TYPE OF COMPLETION: (Circle One or More): Gravel Packed, Underreamed, Telescoped, <input checked="" type="radio"/> Natural Development, Open Hole, Other (Describe) _____		
Top of Lap Pipe or Reduction in Casing		
FEET		IF TELESCOPED OR MORE THAN ONE SCREEN: USE BACK PAGE

LOG DATA	
TYPE OF LOG RUN (Circle One): Electric, Gamma Ray, Density, <input checked="" type="radio"/> No Log Run, Sonic, Neutron Other (Describe) _____	
Name of Organization Running Log	

SCREEN DATA		
Diameter - Inches 2"	Length - Feet 10'	Slot Size - Inches .008
Screen Type PVC	Depth to Bottom - Feet 64'	

GEOLOGIC DATA (Office Use Only)			
Surface Elev.	Geologic Unit	Unit Thickness	Depth to Top
Subs. SWL	Date	Analysis	Aquifer Test


Driller's Remarks

DESCRIPTION OF FORMATIONS ENCOUNTERED	FROM	TO	FORMATIONS CONTINUED
Top soil	0	2	<div style="font-size: 2em; font-weight: bold; opacity: 0.5;">RECEIVED</div> <p style="font-size: 1.2em; margin-top: 10px;">MAY 24 1988</p> <p style="font-size: 0.8em; margin-top: 10px;">Department of Natural Resources Bureau of Land & Water Resources</p>
Blue Clay	2	30	
White Sand	30	64	
Sand	—	—	

IF MORE SPACE IS NEEDED, USE BACK

If well telescopes please sketch and show depths.

GROUND LEVEL

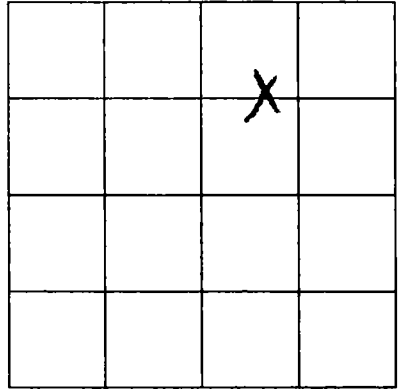

SECTION 14

Please indicate well location X.

ADDITIONAL INFORMATION

If more than one screen,
show location of each on sketch.