

P.O. Box 10631

Jackson, Mississippi 39209

WATER WELL DRILLERS LOG

COUNTY WELL LOCATED
Jackson

WELL NUMBER CODED
5 2255

DATE WELL COMPLETED
11-10-87

PERMIT NUMBER

NAME OF DRILLING FIRM
Coastal Water Well Service

NAME & MAILING ADDRESS OF LANDOWNER
Dewey Reid
9045 Joan St.
Ocean Springs MS

WELL LOCATION: SEC **35** TOWNSHIP **6 N** RANGE **9 E**

DISTANCE **6** Miles DIRECTION **NW** of NEAREST TOWN **Ocean Springs**

OTHER LANDMARK

WELL PURPOSE: Home, Irrigation, Municipal, Industrial, Fish Pond, etc.
home

PUMP DATA

PUMP TYPE (Circle One):
 Submersible, Turbine, **Jet** Flowing Well,
 Other (Describe)

POWER TYPE (Circle One):
Electric, Tractor, Diesel, Gasoline, Butane,
 Other (Describe)

Pump Capacity (GPM) **7'** No. of Stages **1** Setting Depth **—** FT.

PUMP TEST
 Well yielded **—** GPM with
 a drawdown of **—** ft.
 after **—** hours of pumping

WELL DATA

Well Depth 70'	Casing Diameter (In.) 2"	Casing Length (Ft.) 60'
Type of Casing PVC	Hole Depth 70'	Depth to Static Water Level 30'

TYPE OF COMPLETION: (Circle One or More):
 Gravel Packed, Underreamed, Telescoped,
Natural Development, Open Hole, Other

Top of Lap Pipe or Reduction in Casing
 FEET IF TELESCOPED OR MORE THAN ONE SCREEN: USE BACK PAGE

LOG DATA

TYPE OF LOG RUN (Circle One):
 Electric, Gamma Ray, Density, Sonic, **No Log Run**,
 Other (Describe)

Name of Organization Running Log

SCREEN DATA

Diameter - Inches 2"	Length - Feet 10'	Slot Size - Inches .008
Screen Type PVC	Depth to Bottom - Feet 70'	

GEOLOGIC DATA (Office Use Only)

Surface Elev.	Geologic Unit	Unit Thickness	Depth to Top
Subs. SWL	Date	Analysis	Aquifer Test

Driller's Remarks

RECEIVED

DESCRIPTION OF FORMATIONS ENCOUNTERED	FROM	TO
Top Soil	0	2
Blue Clay	2	30
Gray Coarse Sand	30	45
Blue Clay	45	50
Gray Coarse Sand	50	70
Sand	—	—

FORMATIONS COMPLETED FROM TO

MAY 24 1988


Department of Natural Resources
Bureau of Land & Water Resources

IF MORE SPACE IS NEEDED, USE BACK

7506L

If well telescopes please sketch and show depths.

GROUND LEVEL

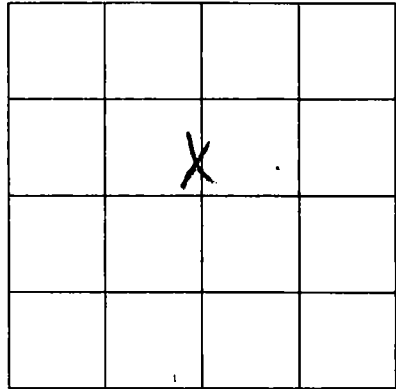

SECTION 35

Please indicate well location X.

ADDITIONAL INFORMATION

Lined area for additional information.

If more than one screen, show location of each on sketch.