

add loc pump pump
MISSISSIPPI DEPARTMENT OF NATURAL RESOURCES
Bureau of Land and Water Resources

P.O. Box 10631

Jackson, Mississippi 39209
WATER WELL DRILLERS LOG

COUNTY WELL LOCATED <i>Jac. Leon</i>	
WELL NUMBER <i>J 2256</i>	CODED
DATE WELL COMPLETED <i>12-30-87</i>	

PERMIT NUMBER
NAME OF DRILLING FIRM <i>Crash Water Well Serv.</i>

NAME & MAILING ADDRESS OF LANDOWNER <i>Sammy Lee Cole</i>		
<i>Old Fort Bayou Rd.</i>		
<i>Vancleave, Ms</i>		
WELL LOCATION: SEC	TOWNSHIP	RANGE
<i>26</i>	<i>6</i>	<i>N 8 E</i>
DISTANCE	DIRECTION	NEAREST TOWN
<i>6</i> Miles	<i>SW</i>	<i>Vancleave</i>
OTHER LANDMARK		
WELL PURPOSE: Home, Irrigation, Municipal, Industrial, Fish Pond, etc. <i>home</i>		

PUMP DATA		
PUMP TYPE (Circle One): Submersible, Turbine, Jet Flowing Well, Other (Describe)		
POWER TYPE (Circle One): Electric Tractor, Diesel, Gasoline, Butane, Other (Describe)		
Pump Capacity (GPM) <i>14</i>	No. of Stages <i>2</i>	Setting Depth <i>40</i> FT.
PUMP TEST Well yielded _____ GPM with a drawdown of _____ ft. after _____ hours of pumping		

WELL DATA		
Well Depth <i>80'</i>	Casing Diameter (In.) <i>2"</i>	Casing Length (Ft.) <i>70'</i>
Type of Casing <i>PVC</i>	Hole Depth <i>80'</i>	Depth to Static Water Level <i>18'</i>
TYPE OF COMPLETION: (Circle One or More): Natural Development , Gravel Packed, Underreamed, Telescoped, Open Hole, Other		
Top of Lap Pipe or Reduction in Casing		
FEET	IF TELESCOPED OR MORE THAN ONE SCREEN: USE BACK PAGE	

LOG DATA	
TYPE OF LOG RUN (Circle One): Electric, Gamma Ray, Density, Sonic, No Log Run , Neutron, Other (Describe)	
Name of Organization Running Log	

SCREEN DATA		
Diameter - Inches <i>2"</i>	Length - Feet <i>10'</i>	Slot Size - Inches <i>1008</i>
Screen Type <i>PVC</i>	Depth to Bottom - Feet <i>80'</i>	

GEOLOGIC DATA (Office Use Only)			
Surface Elev.	Geologic Unit	Unit Thickness	Depth to Top
Subs. SWL	Date	Analysis	Aquifer Test


Driller's Remarks
RECEIVED

DESCRIPTION OF FORMATIONS ENCOUNTERED	FROM	TO	DESCRIPTIONS (Continued)	FROM	TO
<i>Top Soil</i>	<i>0</i>	<i>2'</i>	MAY 24 1988		
<i>Brown Clay</i>	<i>2'</i>	<i>25'</i>	Department of Natural Resources		
<i>White Corner Sand</i>	<i>25'</i>	<i>80'</i>	Bureau of Land & Water Resources		

IF MORE SPACE IS NEEDED, USE BACK

If well telescopes please sketch and show depths.

GROUND LEVEL

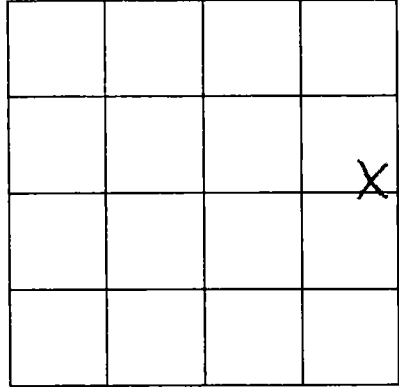

SECTION 26

Please indicate well location X.

ADDITIONAL INFORMATION

If more than one screen, show location of each on sketch.